

Name N.Y. Brothers Realty Trust

Service No. 127

Address 30 Albemarle Avenue

Lot #73-74 Sta. 3&15

Location

Kind of Pipe

Size

Size of Main

~~Repair & Renewal~~ New Service

Location DEC 18 1972


Date	Material	Amount	Total	Date	Amount
9-16-64	Labor	59 88		9-12-72	380 00
	10% O.H.	5 99	65 87	12-18-72	575 43
	20' 6" Transite pipe @ .82		16 40		107 57
	1 6 x 6 Transite tee		4 09		
	1 12" Nipple		1 21		
	2 Hrs. Town shovel @ 6.50		13 00		
	1 Hr. Town truck		3 00		
	1 Hr. Loader		4 00		
			107 57		
10/6/72	33' 6" Transite				
	10' 4" Cast Iron				

Deposit
Refund

DATE _____

TOWN OF LEXINGTON — BOARD OF PUBLIC WORKS
SEWER DIVISION

Sketch of Service Here

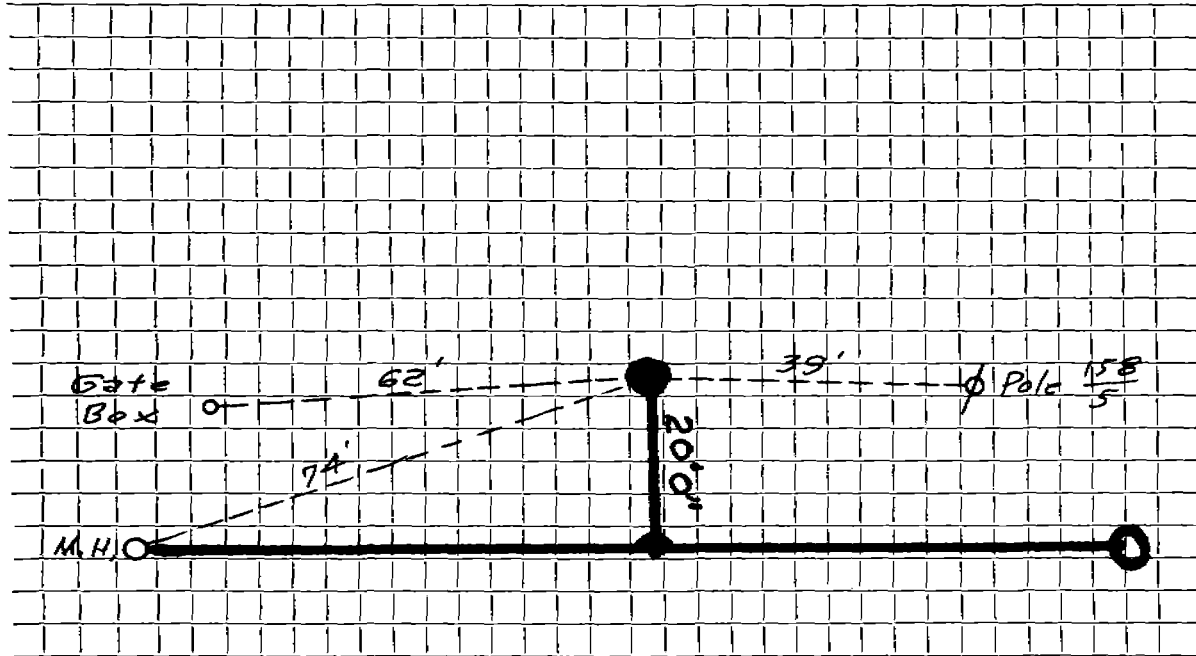

Connection made in Street. Work completed

Remarks:
.....
.....