

Name

Service No.

.Address 35 Albemarle Ave

Lot 101

Location

Kind of Pipe

Size

Size of Main

Repair—Renewal—New Service

Location

Date

Material

Amount

Total

Date

Amount

9-16-64

10' 6" Transite Pipe  
1 12" Nipple


DATE \_\_\_\_\_

TOWN OF LEXINGTON — BOARD OF PUBLIC WORKS

SEWER DIVISION

$\phi$  58/5 Spk. - ~~190.52~~ 190.52 Sketch of Service Here  
INV. Service - ~~178.10~~ 178.10

Rawson Ave  
+  
STA 0+0

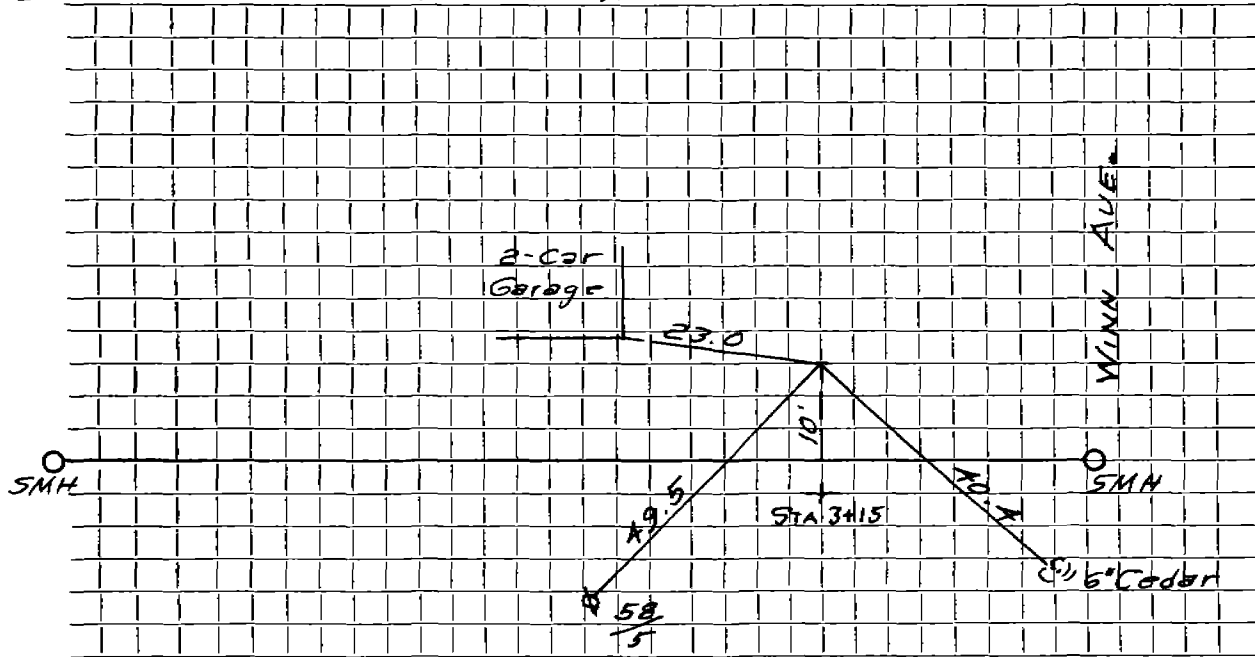

Connection made in ..... Street. Work completed .....

Remarks: .....

.....

.....