

Name Helen Finney

Service No. 39

Address ~~28~~ 70 34 Pitt Eng. Dept
36 Albermarle Ave.

Lexington

Location

Kind of Pipe

COM. 6-16-52

Size

Size of Main

~~Repair~~ ~~Renewal~~ — New Service

Location

Date	Material	Amount	Total	Date	Amount
5/21/52	Labor	59 73		4-14-52	Deposited 150 00
	10% overhead	5 97	65 70	6-16-52	Refunded (25 82)
	50' - 6" sewer pipe @ .342		17 10		124 18
	1 - 6" elbow		1 88		
	joint compound		3 00		
	5 hrs. Littlefield shovel		35 00		
	2 hrs. trucking		1 50		
			124 18		
	Labor				

TOWN OF LEXINGTON—DEPT. OF PUBLIC WORKS
SEWER DIVISION

DATE.....

NO.


The undersigned applies for the construction of a particular sewer connecting No.....
Street and hereby agrees to comply with the Rules and Regulations governing the construction and use of Particular
Sewers, as now or at any future time established by the Board of Selectmen.

Am't of estimate \$.....

Am't Paid \$.....

..... Owner

Sketch of Service Here

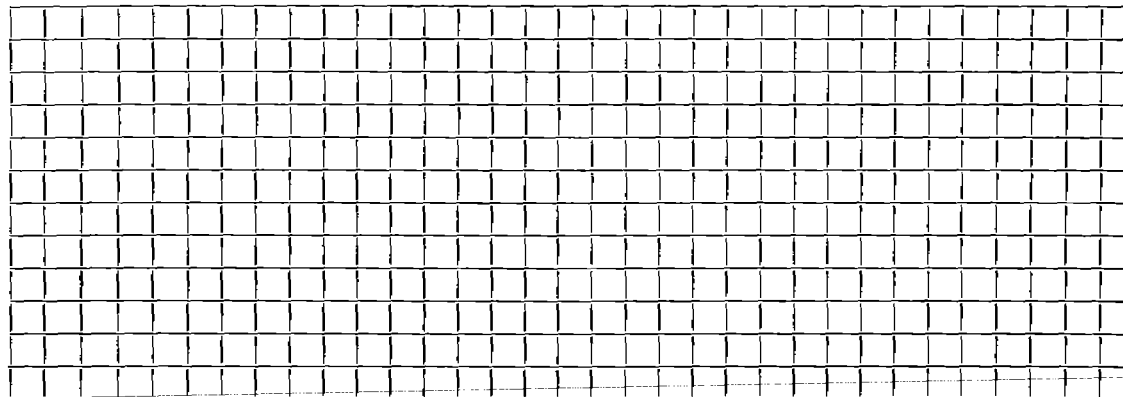

Connection made in..... Street.

Work completed.....19..

Remarks: