


DATE _____

TOWN OF LEXINGTON — BOARD OF PUBLIC WORKS

SEWER DIVISION

STA 0+0
+ Rawson Ave.

$\phi 58/5$ SPK - ~~190.52~~ 190.52 Sketch of Service Here
INV. Service - ~~180.87~~ 180.87

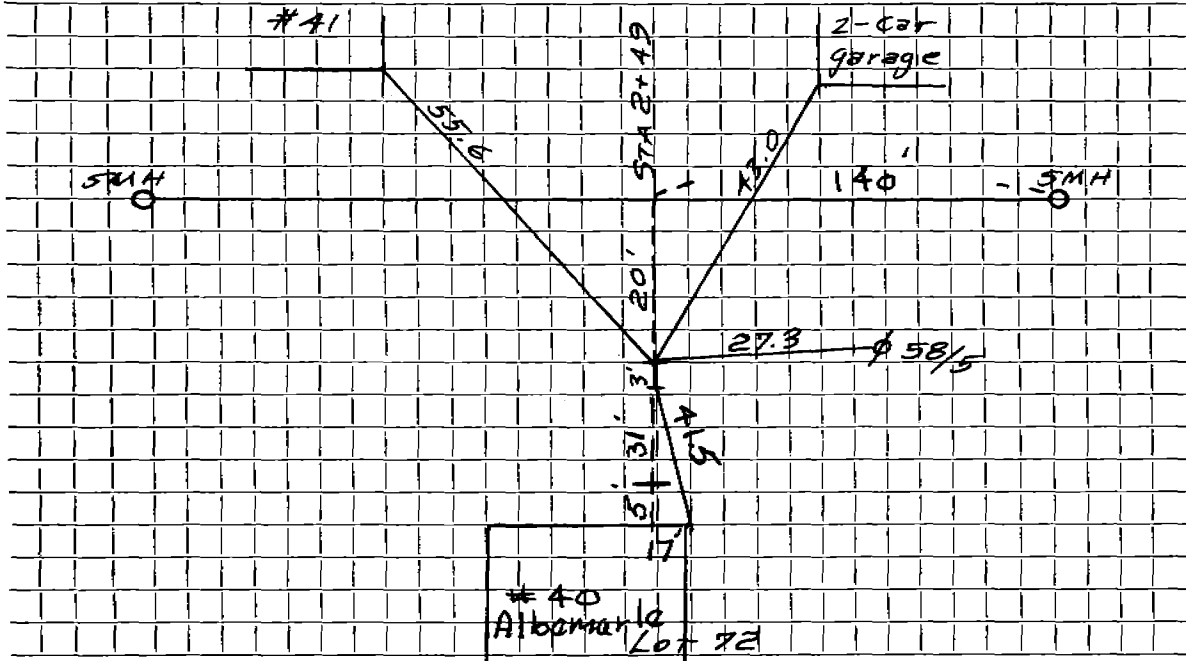

Connection made in Street. Work completed

Remarks:
.....
.....