

Name Robert Dunham

Service No. 161

Address ~~111 5th Street~~

43 Albermarle Avenue

Location

Kind of Pipe

Size

Size of Main

~~REPLACEMENT~~ New Service DeFlice Bros. Permit #A-34 W.O. #945

Location MAR 7 1966

Date	Material	Amount	Total	Date	Amount
9-27-65	Labor	48 88		10-7-65	125 00
	10% O.H.	4 89	53 77	3-14-66	30 69
	16' 6" Transite pipe @ .82		13 12		144 31
	1 90° Elbow		4 09		
	½ Bag Cement @ 1.50		75		
	1 Doz. Brick @ 4.20 per 100		51		
	23 x 7 Patch		53 67		
	6 Ton Gravel @ 1.40		8 40		
	1 Hr. Town Shovel		6 50		
	½ Hr. Loader @ 4.00		2 00		
	½ Hr. Town Truck @ 3.00		1 50		
			114 31		
10-7-65	23' 6" Transite pipe				


\* Applied to W.O. #945

DATE \_\_\_\_\_

# TOWN OF LEXINGTON — BOARD OF PUBLIC WORKS

## SEWER DIVISION

Sketch of Service Here

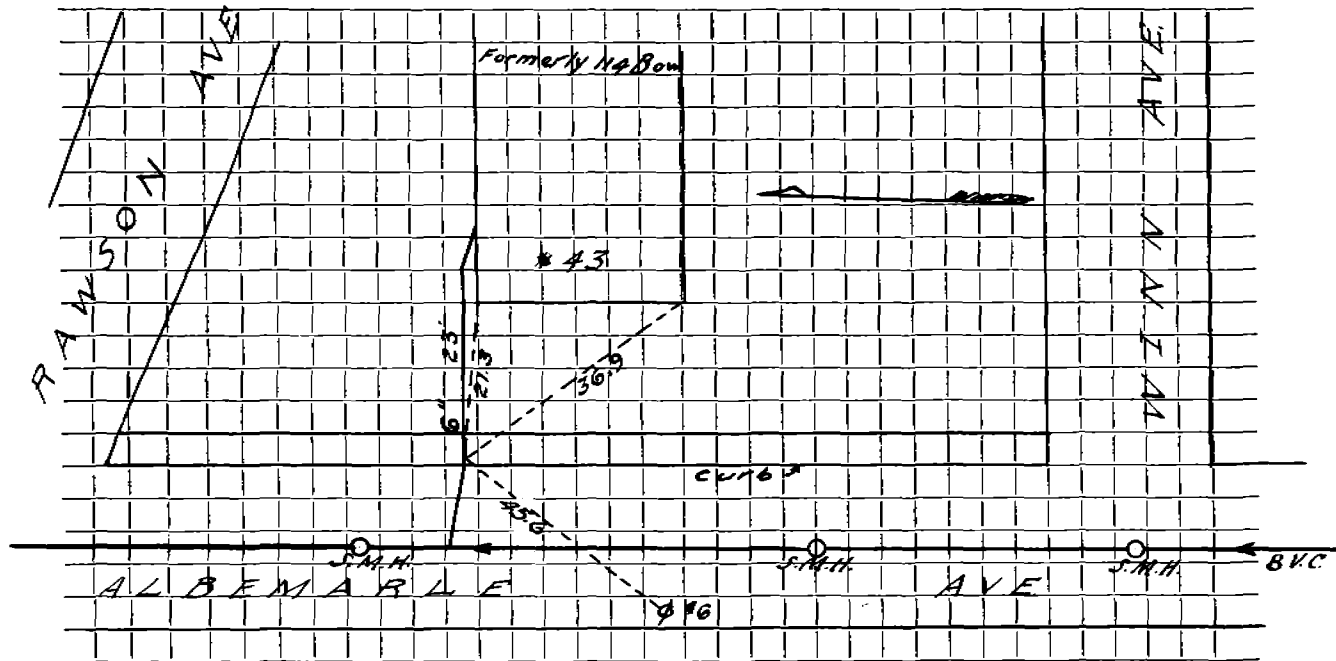

Connection made in ..... Street. Work completed .....

Remarks: .....  
.....  
.....