

Name William E. Maloney Jr.

Service No.

Address 59 Albemarle Avenue

Lot #34

Location

Kind of Pipe

Size

Size of Main

~~Repair~~ ~~Renewal~~ **New Service**

David Eagle Permit #239


Location

Date		Material	Amount	Total	Date		Amount
Apr '65	40'	6" Transite pipe					
	55'	6" Transite (M.H. to Curb)					
	20'	6" Transite (Curb to house)					
	20'	Cast Iron					

DATE _____

TOWN OF LEXINGTON — BOARD OF PUBLIC WORKS
SEWER DIVISION

Sketch of Service Here

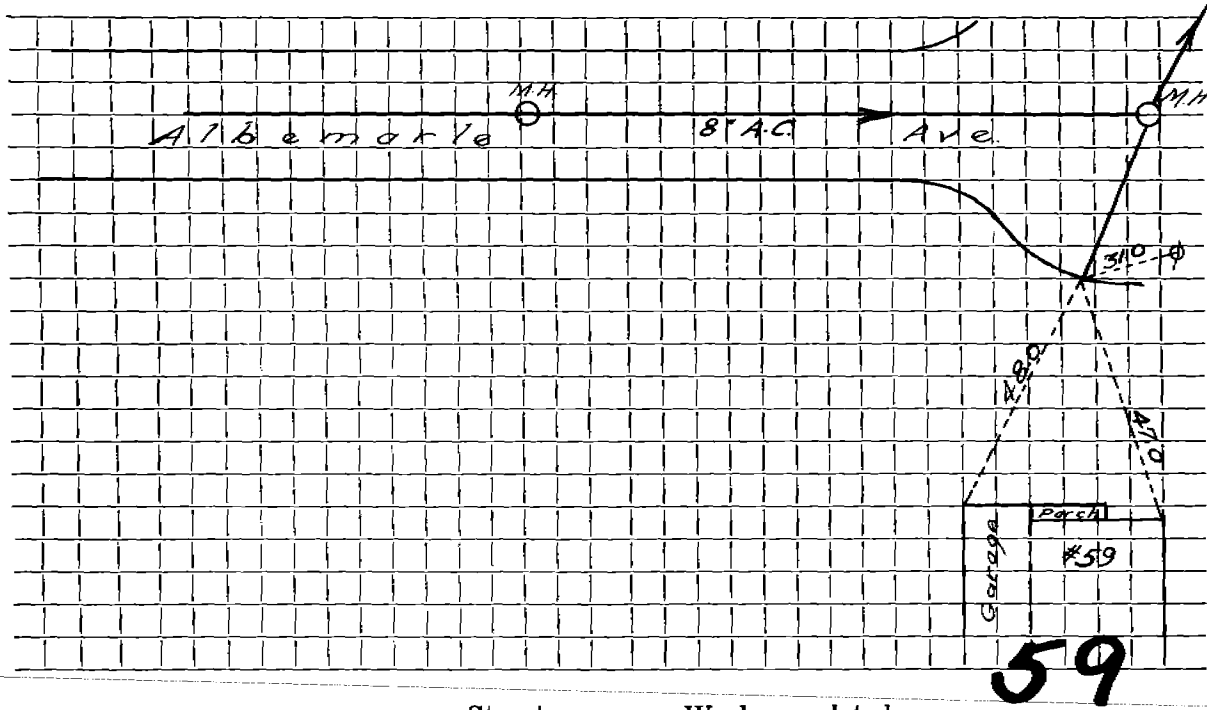

Connection made in Street. Work completed

Remarks:
.....
.....