

Name Richard A. Hemstreet

Service No. 58

Address 6 Albermarle Avenue

Lexington

Location 6 Albermarle Avenue

Kind of Pipe

Size

Size of Main

Repair - Renewal - New Service

Com. 11-6-50

Location

Date	Material	Amount	Total	Date	Amount
Sept. 11 '50	Labor	40 80		Aug. 7 '50	150 00
" 12 "	"	24 73		7-2-54	27 78
" 13 "	"	13 23			177 78
	10% Overhead	7 88	86 64		
	40' - 6" Sewer Pipe		11 20		
	1 - 6"-1/8 Bend		1 52		
	Joint Compound		2 40		
	3 lbs. Dynamite		66		
	3 Caps		36		
	2 hrs. Compressor @ \$1.75		3 50		
	10 hrs. Littlefield Shovel		70 00		
	2 hrs. Trucking		1 50		
	Labor		177 78		

TOWN OF LEXINGTON—DEPT. OF PUBLIC WORKS

**SEWER DIVISION**

DATE .....

NO. ....


The undersigned applies for the construction of a particular sewer connecting No. ....  
Street and hereby agrees to comply with the Rules and Regulations governing the construction and use of Particular  
Sewers, as now or at any future time established by the Board of Selectmen.

Am't of estimate \$. ....

Am't Paid \$. ....

..... Owner

**Sketch of Service Here**

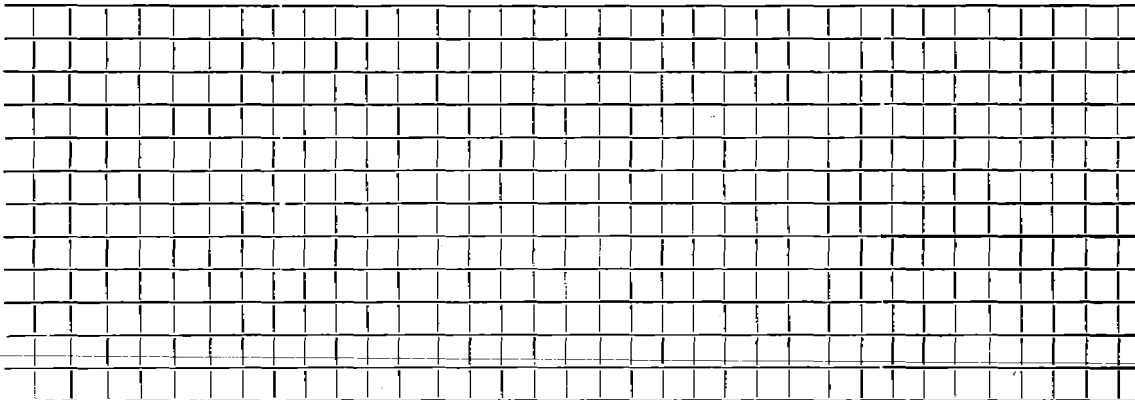

Connection made in ..... Street.

Work completed ..... 19..

Remarks:

