

Name

Service No.

Address #11 ALCOTT RD

Location

Kind of Pipe A.C.

Size 6"

Size of Main 8"

Repair—Renewal—New Service


Location

Date		Material	Amount	Total	Date		Amount
7/12	77	58'-6" KP @	10.00	580 00			

DATE _____

TOWN OF LEXINGTON — BOARD OF PUBLIC WORKS
SEWER DIVISION

Sketch of Service Here

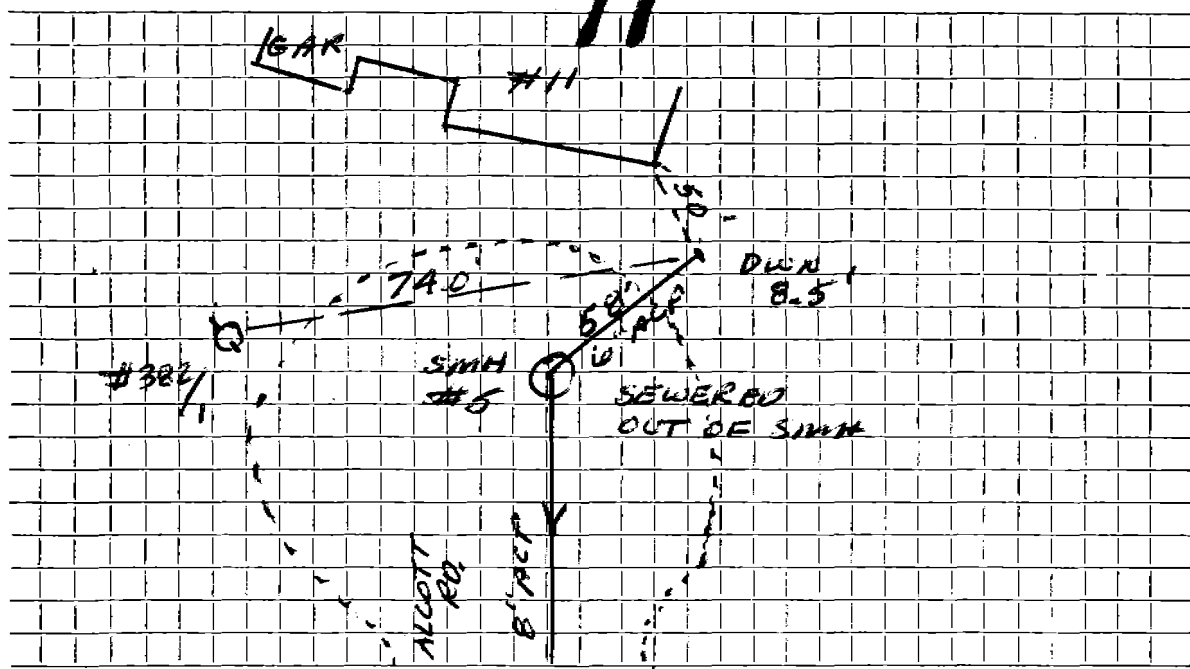

Connection made in Street. Work completed

Remarks:
.....
.....