

Name

Service No.

Address #4 ALCOTT RD.

Location

Kind of Pipe A.C.

Size 6"

Size of Main 10"

Repair—Renewal—New Service


Location

Date		Material	Amount	Total		Date		Amount
7-7	77	28' - 6" ACP @	10.00	\$280	00			

DATE \_\_\_\_\_

TOWN OF LEXINGTON — BOARD OF PUBLIC WORKS  
SEWER DIVISION

Sketch of Service Here

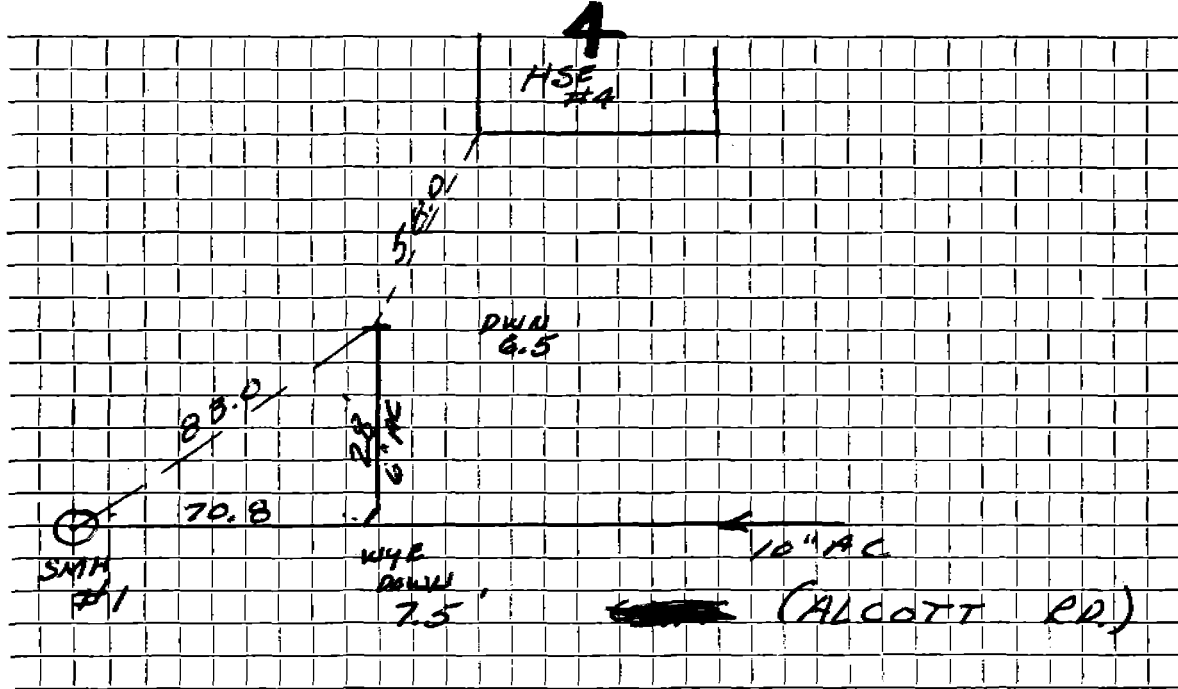

Connection made in ..... Street. Work completed .....

Remarks: .....

.....  
.....