

Name

Service No.

Address

5 Alcott Rd

Location

Kind of Pipe

PVC

Size

6"

Size of Main

8"

Repair—Renewal—New Service

Location

Date

Material

Amount

Total

Date

Amount

10-22-01

Inside installed

7-11-77


24' - 6" AC

2- 6x6x6 wye clean outs
6x6 PVC to AC adapt
1- 22° Bend
148' - 6" PVC

DATE _____

TOWN OF LEXINGTON — BOARD OF PUBLIC WORKS
SEWER DIVISION

Sketch of Service Here

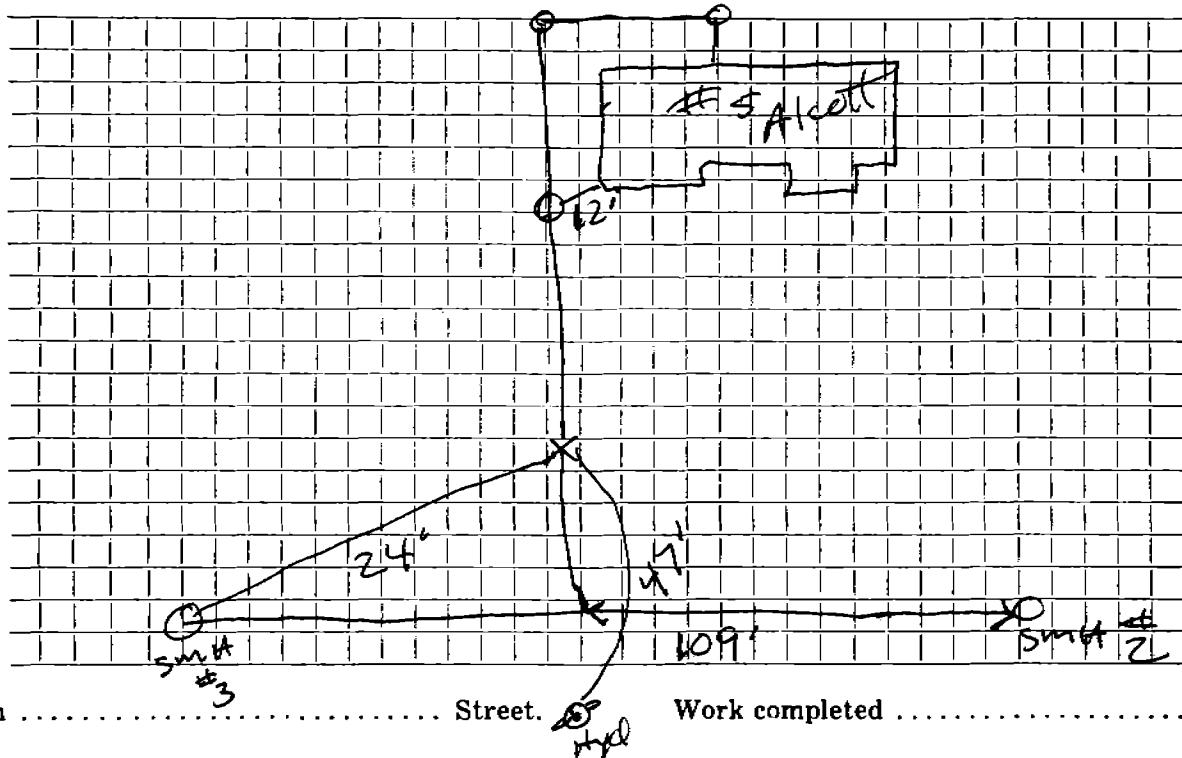

Connection made in Street. Work completed

Remarks:

.....

.....