




DATE 1/5/93

TOWN OF LEXINGTON — BOARD OF PUBLIC WORKS  
SEWER DIVISION

Sketch of Service Here

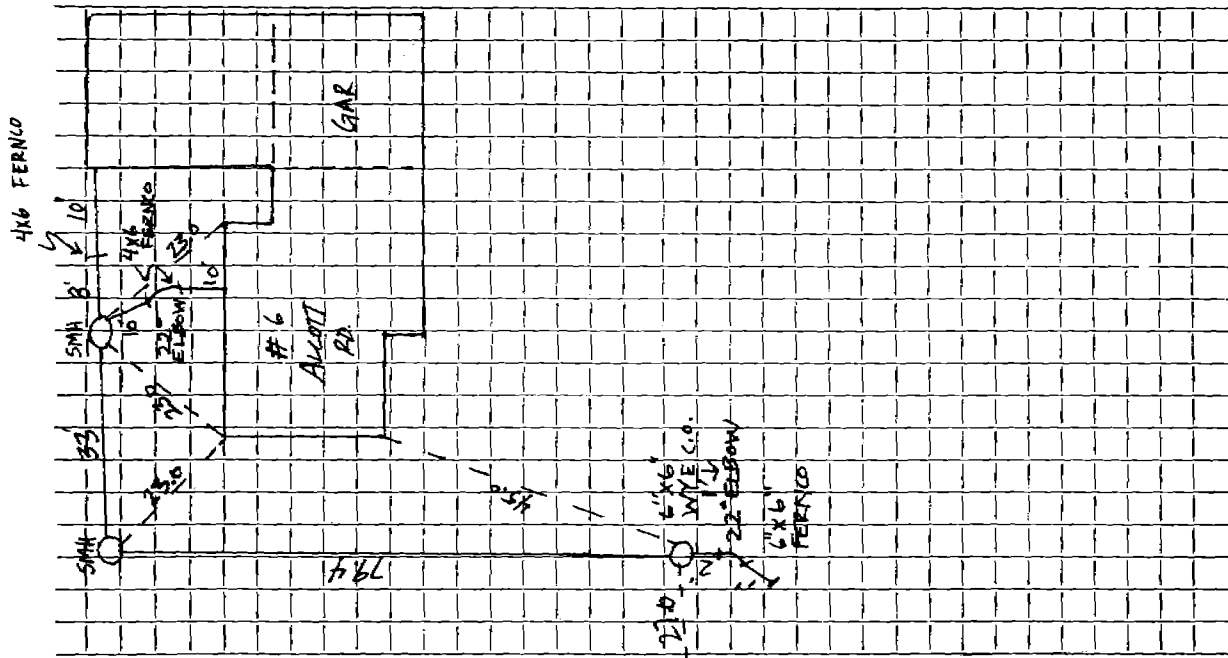

Connection made in ..... Street. MD Work completed 5/19/93 GAYLOR, INC.

Remarks: .....  
.....  
.....