


DATE 8/17/89

TOWN OF LEXINGTON — BOARD OF PUBLIC WORKS
SEWER DIVISION

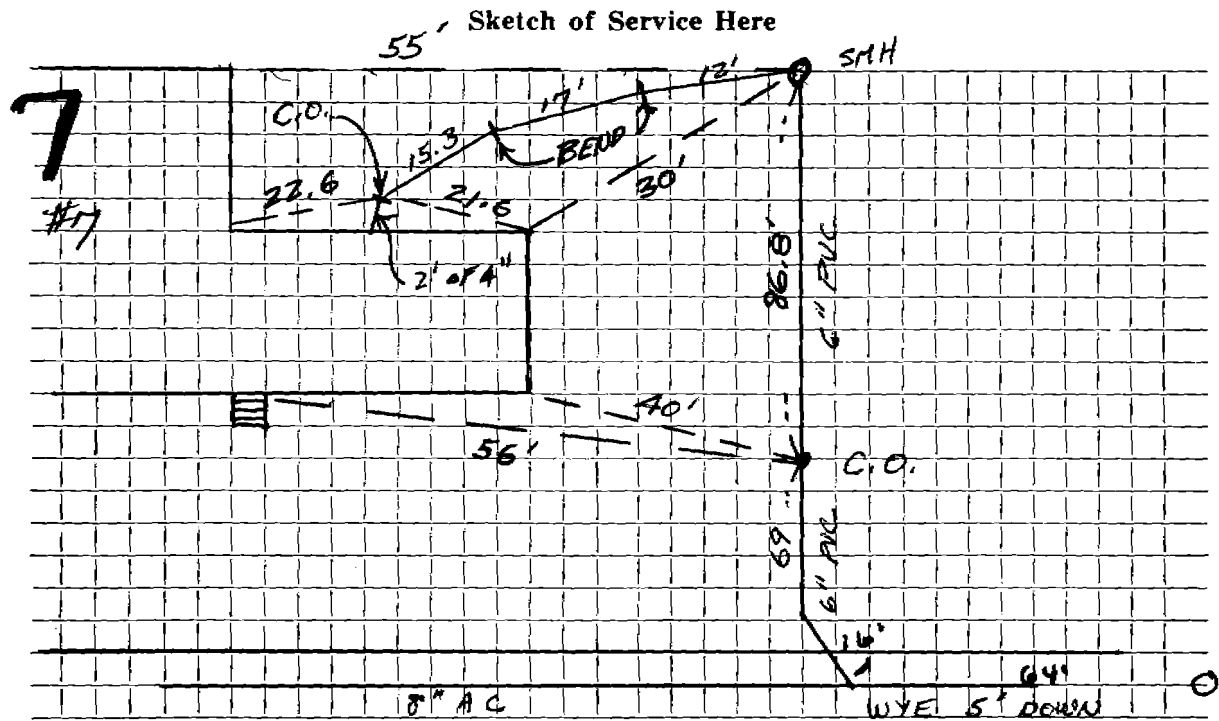

Connection made in ALCOTT RD.... 8" AC... Street. Work completed

Remarks: CONTR: VALERI CONSTR.... INSP: M. BILILIES.....