




DATE \_\_\_\_\_

TOWN OF LEXINGTON — BOARD OF PUBLIC WORKS  
SEWER DIVISION

Sketch of Service Here

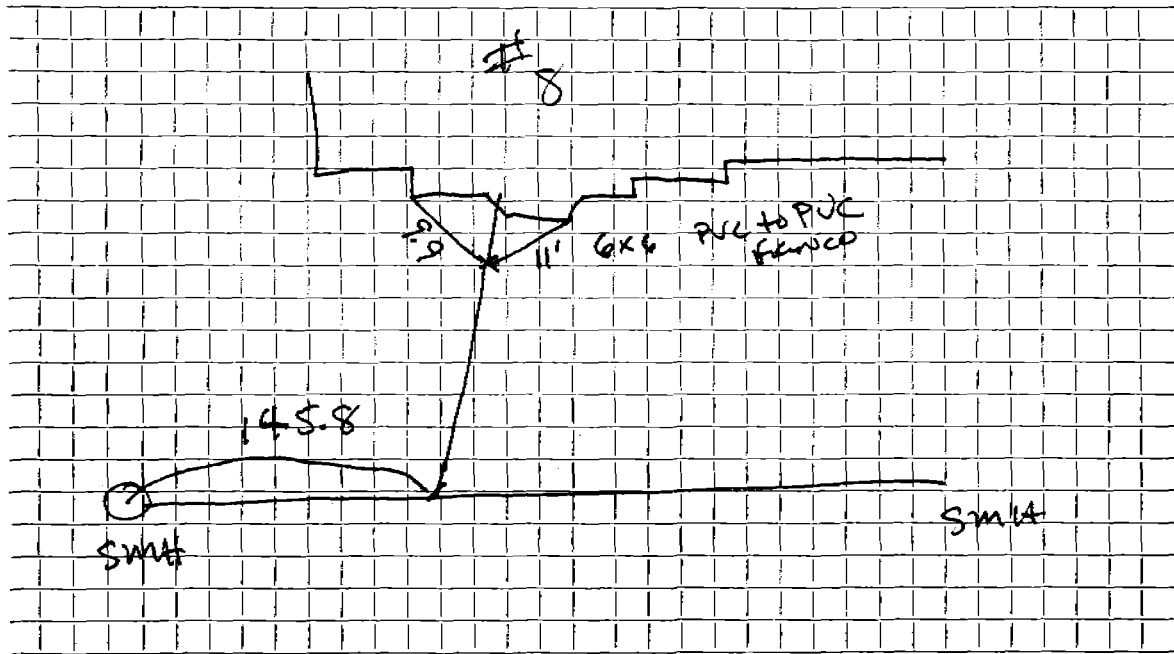

Connection made in ..... Street. Work completed .....

Remarks: Old house torn down ties  
off new foundation.

Name

Service No.

Address # 8 ALCOTT RD.

Location

Kind of Pipe AC.

Size 6"

Size of Main 8"

Repair—Renewal—New Service

Location

Date	Material	Amount	Total	Date	Amount
------	----------	--------	-------	------	--------

77	77 26'-6" AC @	\$ 10.00	\$ 260.00		
----	----------------	----------	-----------	--	--

DEC. 1, 1998 INSIDE INSTALLED

109' 6" PVC

2-6x6x6 WYE CLEAN OUTS


1-4x6 CI to PVC FARNCO

1-6x6 AC to PVC FARNCO

DATE \_\_\_\_\_

TOWN OF LEXINGTON — BOARD OF PUBLIC WORKS

SEWER DIVISION

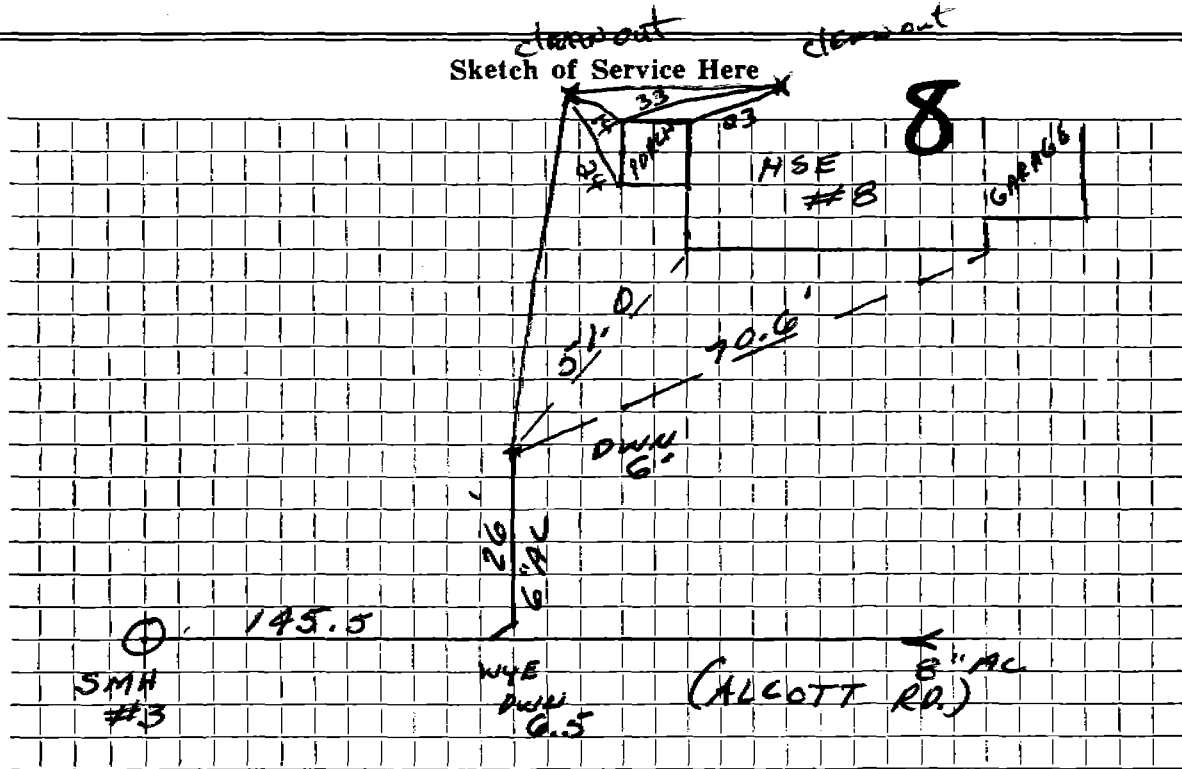

Connection made in ..... Street. Work completed .....

Remarks: .....  
.....  
.....