

Name Robert T. Sanford

Service No. 100

Address #9 ALCOTT RD.

Location

Kind of Pipe AC

Size 6"

Size of Main 8"

Repair—Renewal—New Service

#3054

Sub. Cesspool #3054

Location

FEB 13 1978

SUBURBANITE


Date	Material	Amount	Total	Date	Description	Amount
7/11/77	16' - 6" AC @	\$10.00	\$ 160.00	11-14-77	Deposit	160.00
11/15/77	96' - 6" ACP 61.5' - 4" ACP					

.B.N. 18501

DATE _____

TOWN OF LEXINGTON — BOARD OF PUBLIC WORKS
SEWER DIVISION

Sketch of Service Here

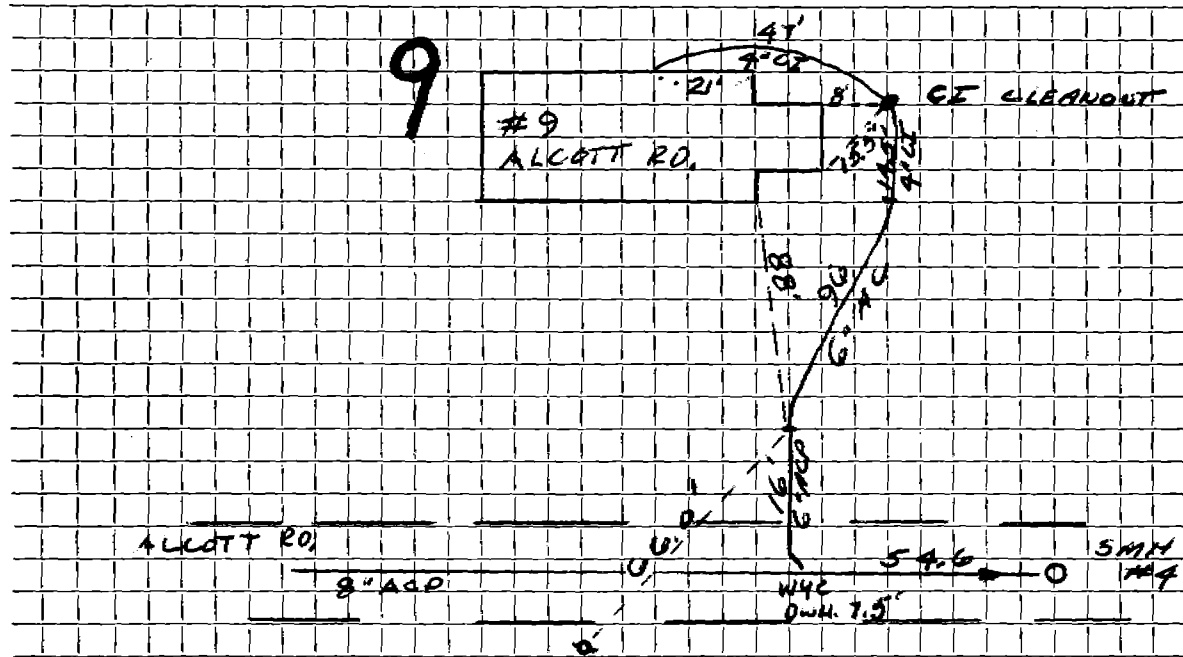

DATE #382/2

Connection made in ... ALCOTT R.D. ... Street. Work completed

Remarks:
.....
.....