

Name

Service No.

Address #11 Allen St.

Location

Kind of Pipe

Size

Size of Main

Repair—Renewal—New Service

inside

Location

Date

Material

Amount

Total

Date

Amount

4-23-71


70'-6" Transit
(Dry-Sewer)

DATE _____

TOWN OF LEXINGTON — BOARD OF PUBLIC WORKS

SEWER DIVISION

Sketch of Service Here

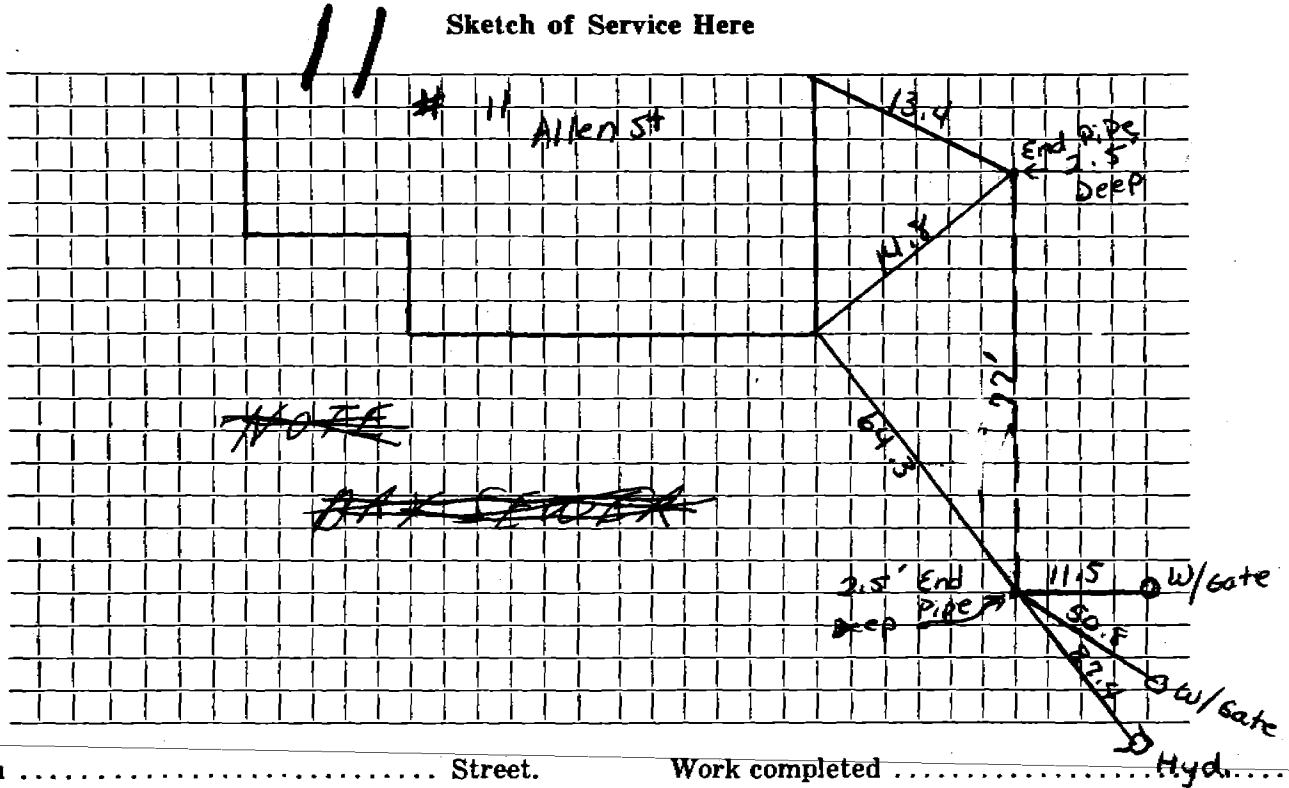

Connection made in Street. Work completed Hyd.....

Remarks:

.....

.....

Name Kathy White

Service No.

Address 11 ALLEN Street

Location

Kind of Pipe PVC

Size 6"

Size of Main

Repair—Renewal—New Service

Paul Rose CONTRACTOR

PERMIT # 1339

Location DIG SAFE 1999-4600 - 409

Date	Material	Amount	Total	Date	Amount
------	----------	--------	-------	------	--------

Nov 8 99

1 6" ELBOW


8' 6" PVC.

TSM

DATE Nov 8 1999

TOWN OF LEXINGTON — BOARD OF PUBLIC WORKS
SEWER DIVISION

Sketch of Service Here

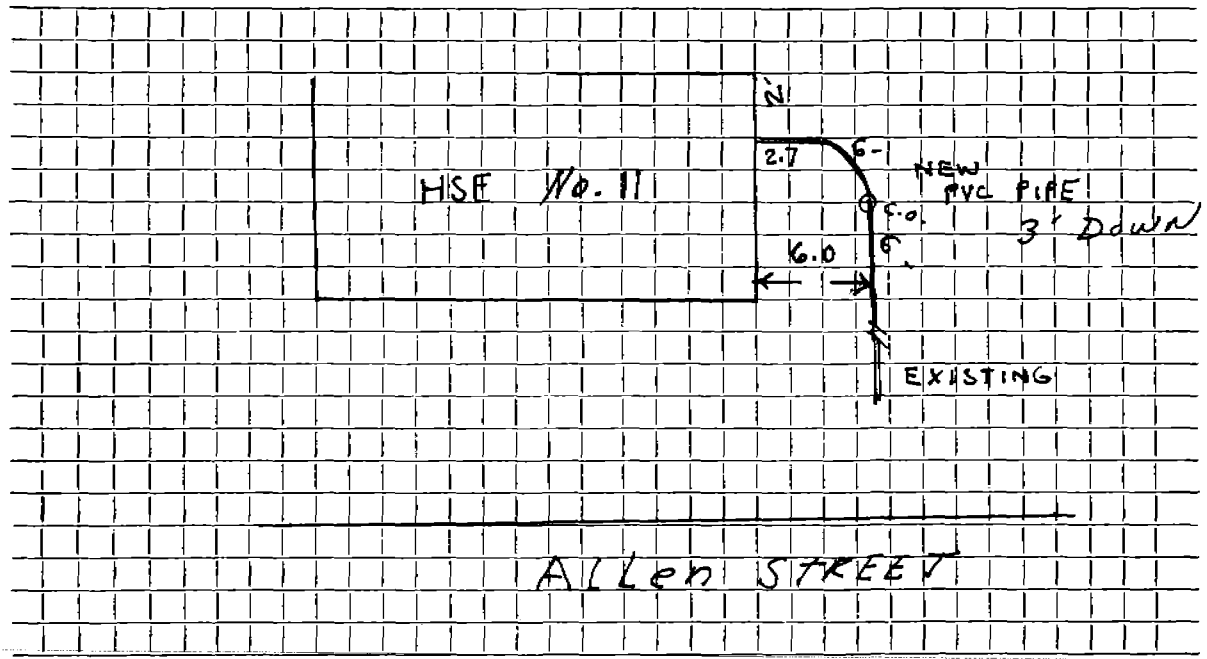

Connection made in Street. Work completed

Remarks:
.....
.....