

Name *PETER EGGONOMPOULAS*

Service No.

Address *15 Allen St.*

Location

Kind of Pipe *PVC*

Size *6"*

Size of Main *8"*


Repair—Renewal—New Service *SEWER MAN # 1318*

Location

| Date            | Material                 | Amount       | Total         | Date | Amount |
|-----------------|--------------------------|--------------|---------------|------|--------|
| <i>4/27 83</i>  | <i>30 LF 6" PVC</i>      | <i>16.00</i> | <i>480.00</i> |      |        |
| <i>10-16 99</i> | <i>77 LF 6" PVC</i>      |              |               |      |        |
| <i>10-16 99</i> | <i>2-22 1/2° BEND</i>    |              |               |      |        |
| <i>10-16 99</i> | <i>1-45° Y CLEAN OUT</i> |              |               |      |        |
|                 |                          |              |               |      |        |
|                 |                          |              |               |      |        |
DATE 7-14-83

TOWN OF LEXINGTON — BOARD OF PUBLIC WORKS  
SEWER DIVISION

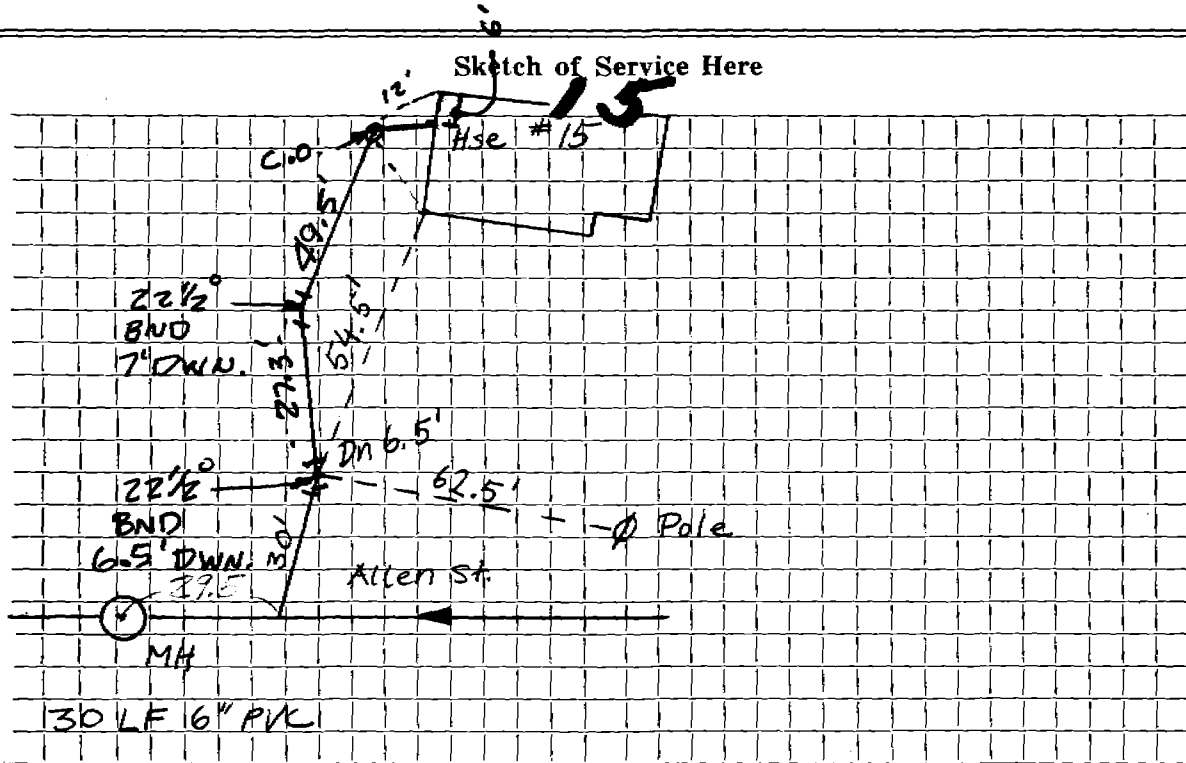

Connection made in ALLEN Street. Work completed .....

Remarks: .....

.....

.....