


DATE 7-14-83

TOWN OF LEXINGTON — BOARD OF PUBLIC WORKS
SEWER DIVISION

Sketch of Service Here

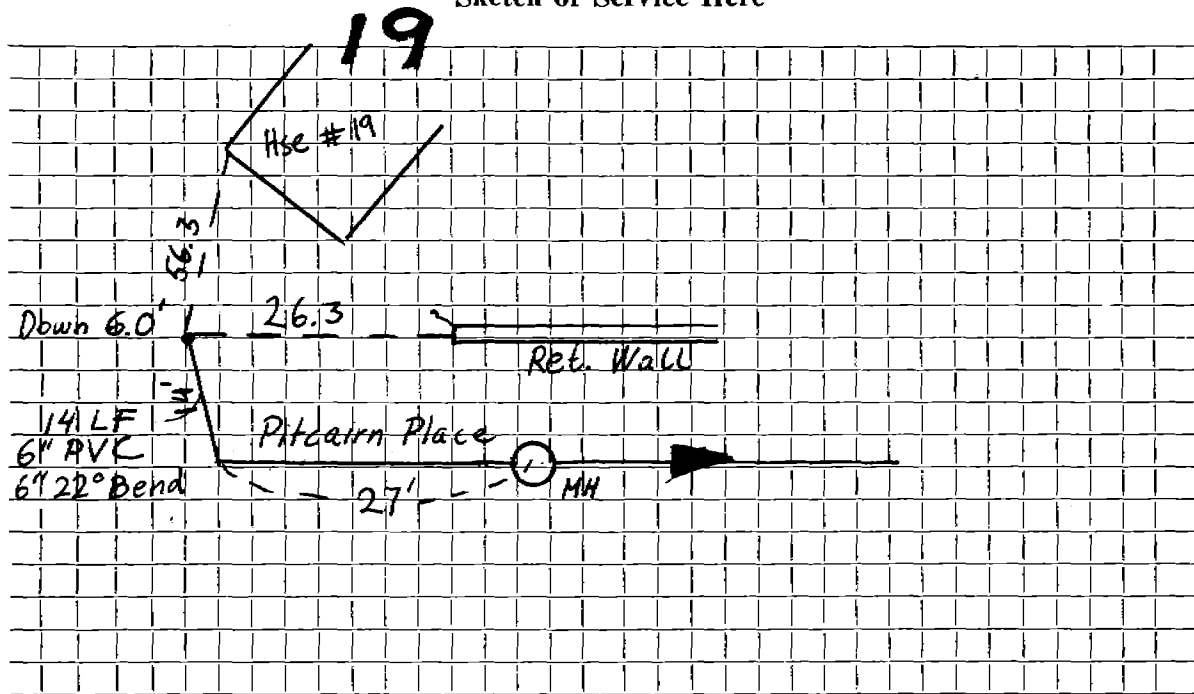

Connection made in PITCAIRN PLACE ST. Street. Work completed

Remarks: