

Name 1

Service No.

Address 23 ALLEN ST.

Location

Kind of Pipe PVC

Size 6"

Size of Main 8"

Repair—Renewal—New Service


Location

Date		Material	Amount		Total		Date		Amount	
4/26	83	34 LF 6" PVC	16	00	544	00				

DATE 7-14-83

TOWN OF LEXINGTON — BOARD OF PUBLIC WORKS  
SEWER DIVISION

Sketch of Service Here

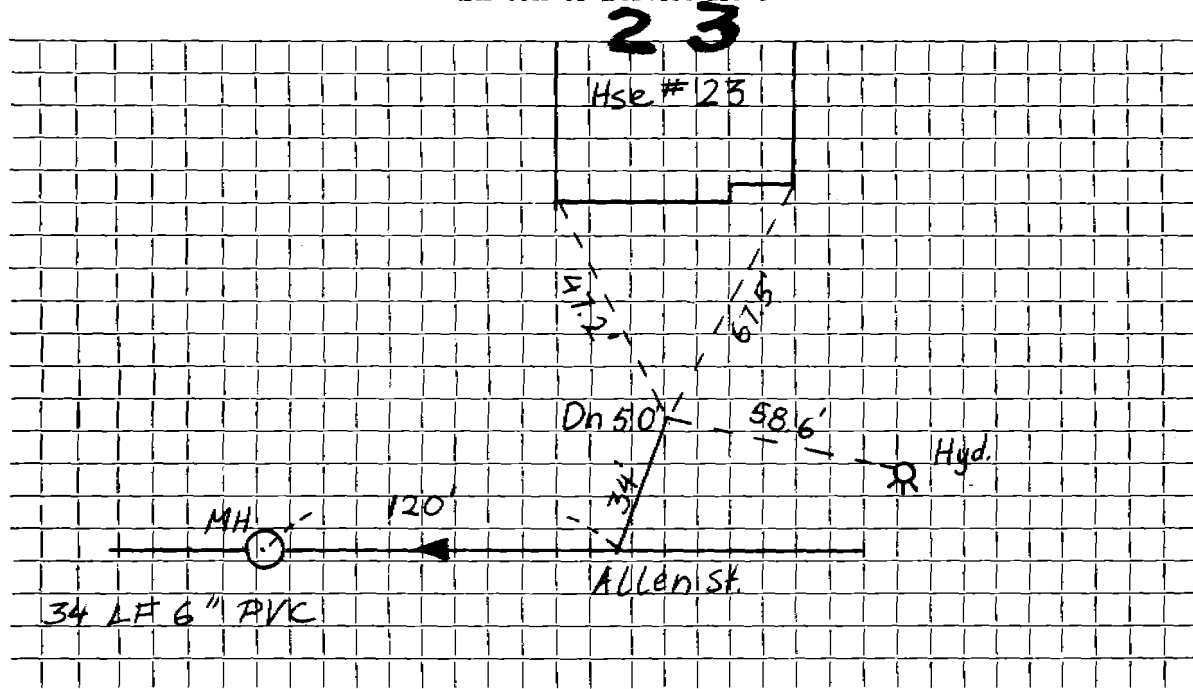

Connection made in .. ALLEN ST. .... Street. Work completed .....

Remarks: .....

.....

.....