

Name

Service No.

Address 29 ALLEN ST

Location

Kind of Pipe PVC

Size 6"

Size of Main 8"

Repair—Renewal—(New Service)

Location

Date

Material

Amount

Total

Date

Amount

1/26 89

142' PVC 6"
WYE
CLEANOUT

4/28/83


40' LF 6" PVC

16. - ~~4~~ CHD -

DATE _____

TOWN OF LEXINGTON — BOARD OF PUBLIC WORKS
SEWER DIVISION

Sketch of Service Here

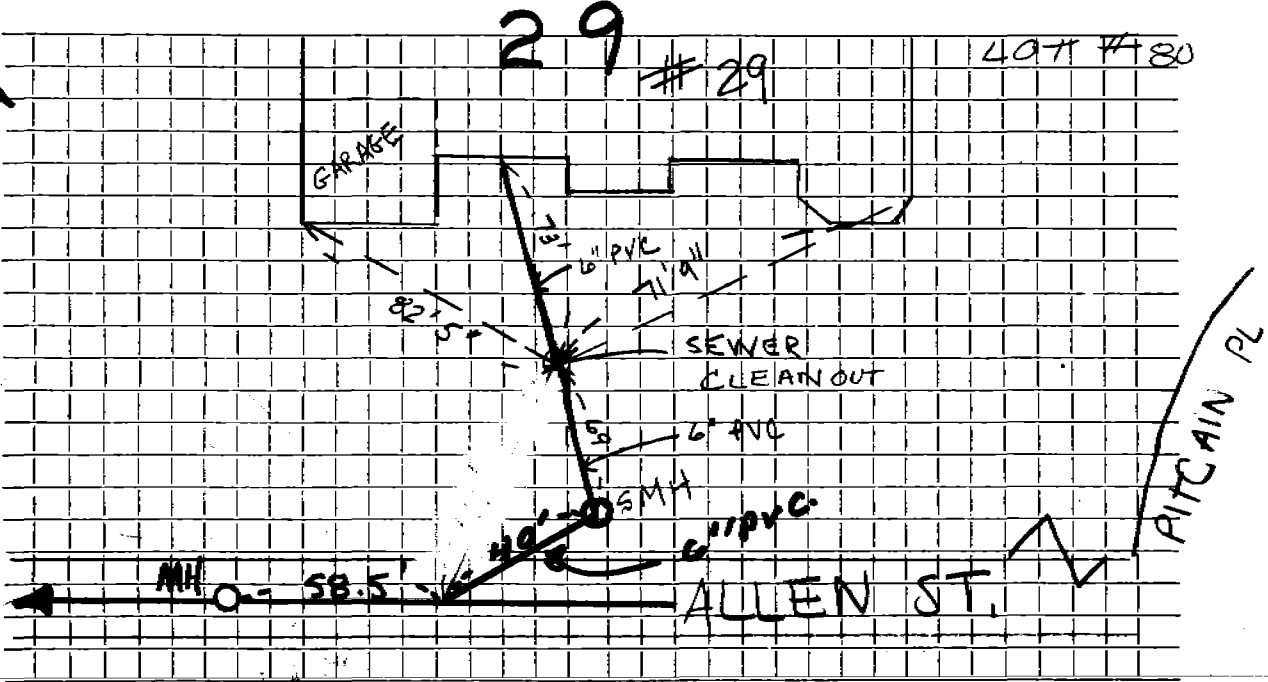

Connection made in Street. Work completed

Remarks:
.....
.....