




DATE \_\_\_\_\_

TOWN OF LEXINGTON — BOARD OF PUBLIC WORKS

SEWER DIVISION

Sketch of Service Here

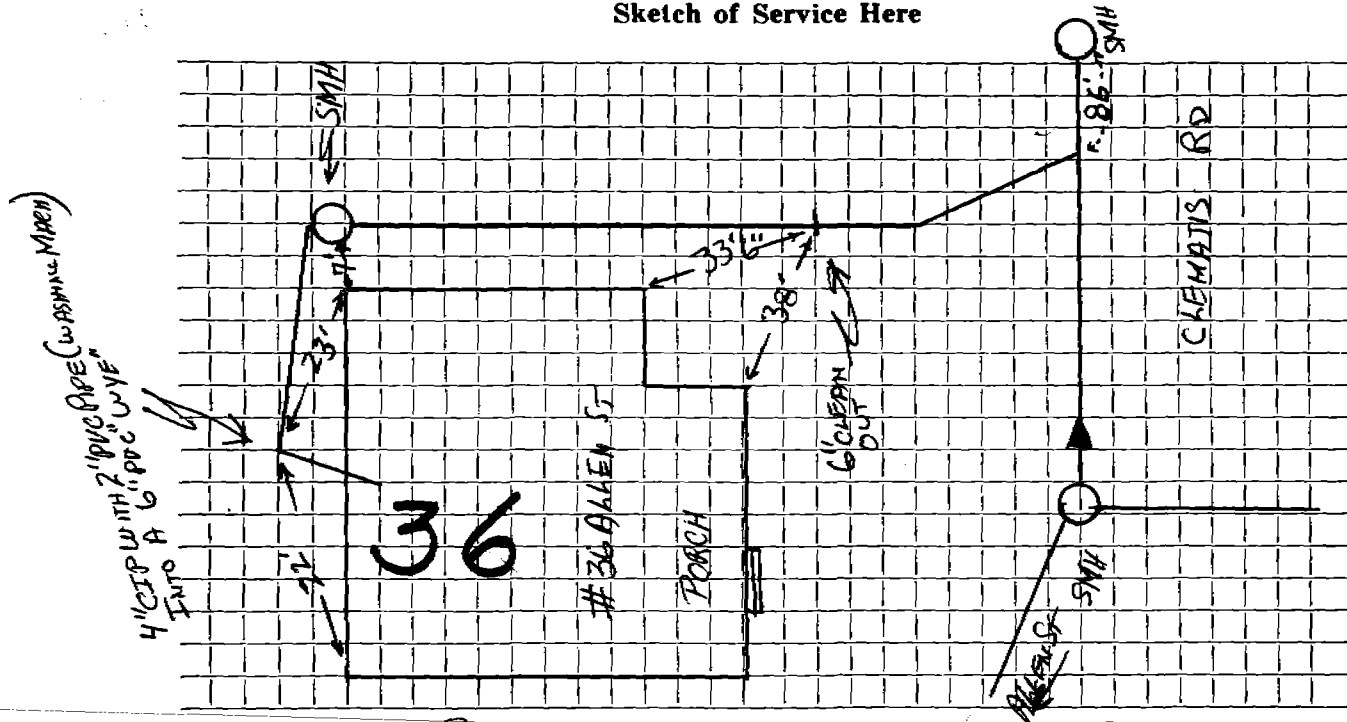

Connection made in CLEMAJIS RD Street.

Work completed SEPT 14, 1983

Remarks: .....

.....

.....