

Name

Service No.

Address 41 ALLEN STREET

Location

Kind of Pipe PVC

Size 6"

Size of Main 8"

Repair—Renewal—New Service

Location

Date		Material	Amount	Total	Date	Amount
4/25	83	20 LF 6" PVC	16 00	320 00		


P.L.N. 18501

DATE 7-14-83

TOWN OF LEXINGTON — BOARD OF PUBLIC WORKS  
SEWER DIVISION

41

Sketch of Service Here

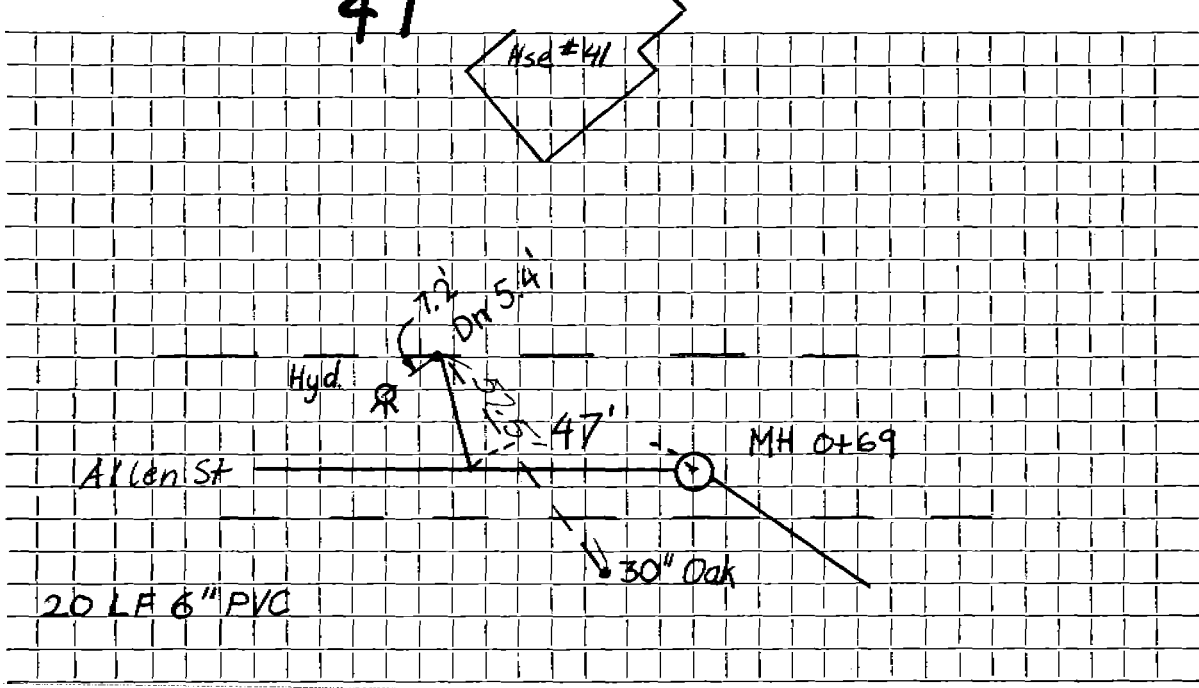

20 LF 6" PVC

MH 0+69

30" Oak

Connection made in Allen St. Street. Work completed .....

Remarks: .....  
.....  
.....