




DATE \_\_\_\_\_

**TOWN OF LEXINGTON — BOARD OF PUBLIC WORKS**  
**SEWER DIVISION**

Sketch of Service Here

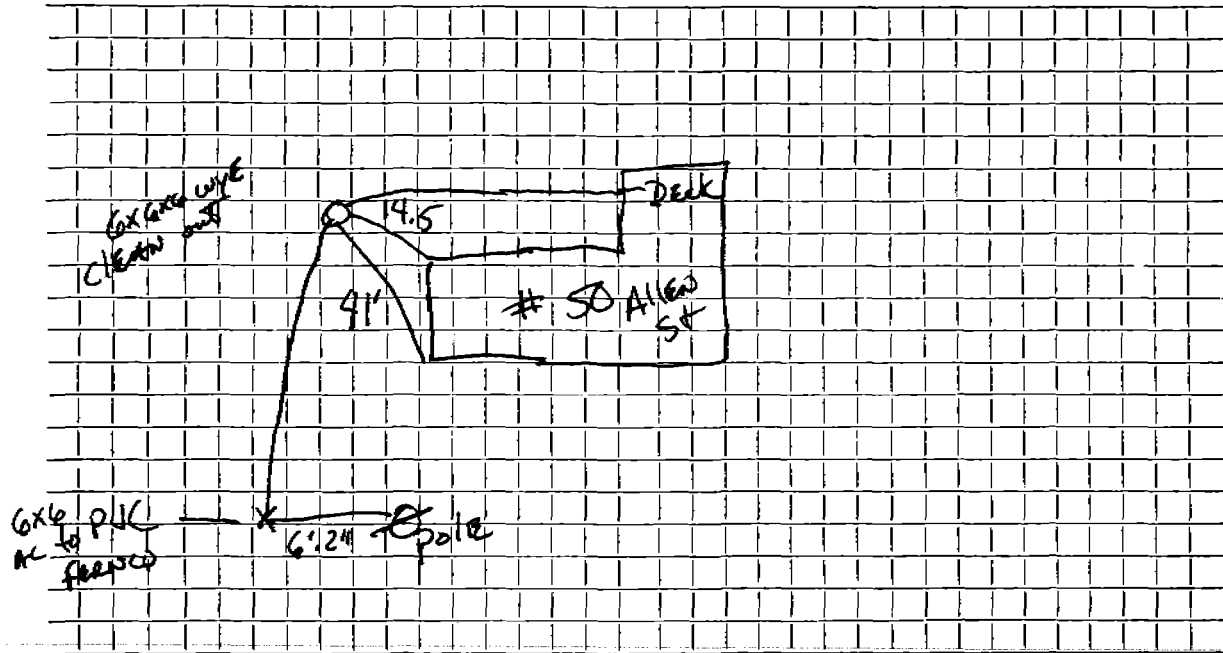

Connection made in A. L. L. R. N. Street. Work completed .....

Remarks: INSTALLED BY B. MCKEE .....