


DATE _____

TOWN OF LEXINGTON — BOARD OF PUBLIC WORKS

SEWER DIVISION

Sketch of Service Here

- ① A
32'
- ② 64'

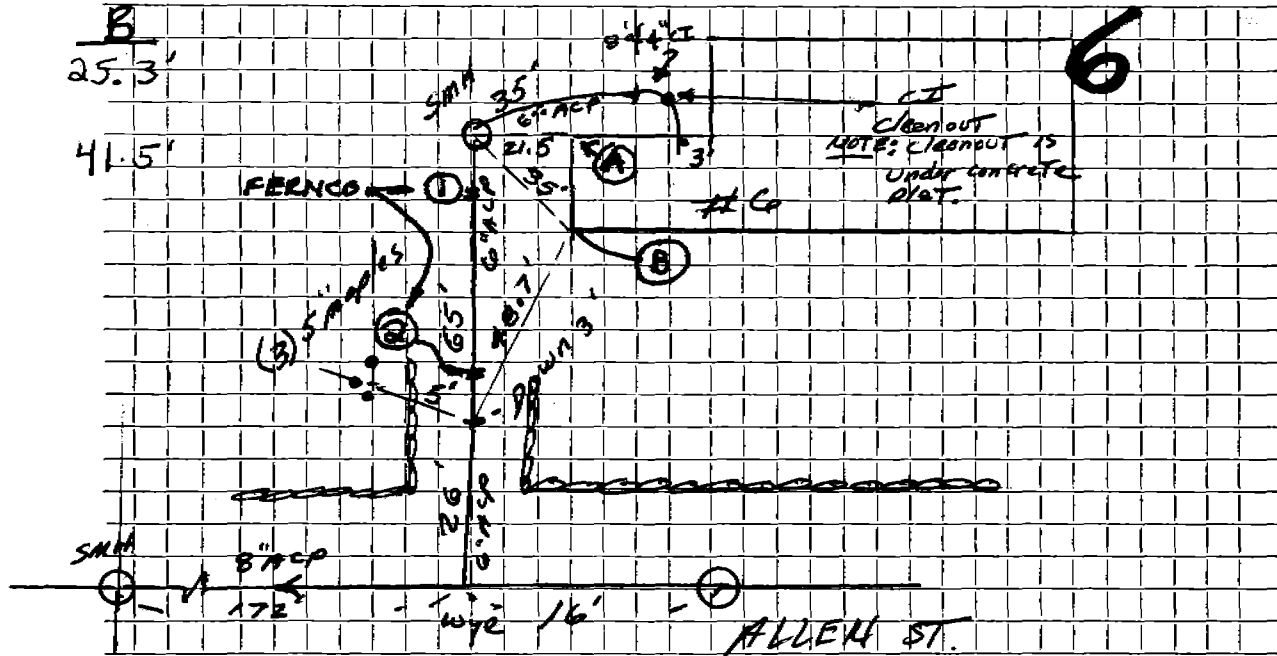

Connection made in ALLEN Street. Work completed

Remarks: PIPE REPLACED 1-2 → 9/16/1997

Book 97-3