


DATE APRIL 29, 1983

TOWN OF LEXINGTON — BOARD OF PUBLIC WORKS
SEWER DIVISION

Sketch of Service Here

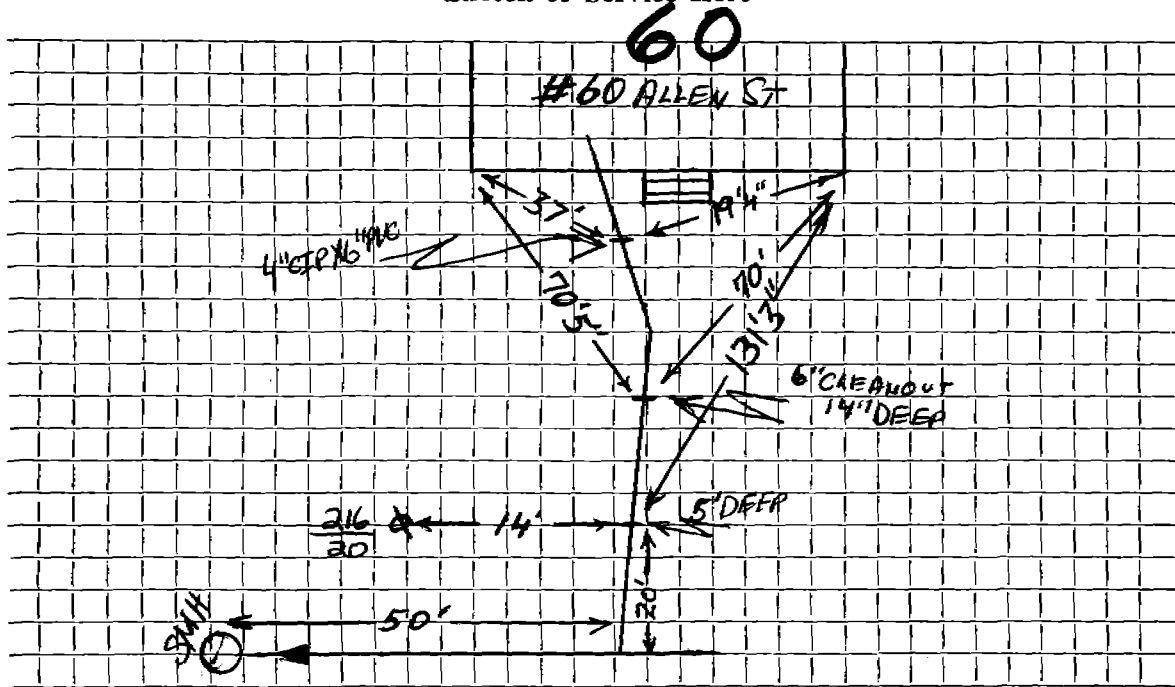

Connection made in ALLEN ST Street. Work completed OCT. 5, 1983

Remarks:

.....

.....