

Name

Service No.

Address 66 ALLEN STREET

Location

Kind of Pipe PVC

Size 6"

Size of Main 8"

Repair—Renewal—New Service


Location

Date	Material	Amount	Total	Date	Amount
4/29 83	18 LF 6" PVC	16.00	288.00		

DATE 7-14-83

TOWN OF LEXINGTON — BOARD OF PUBLIC WORKS
SEWER DIVISION

66 Sketch of Service Here

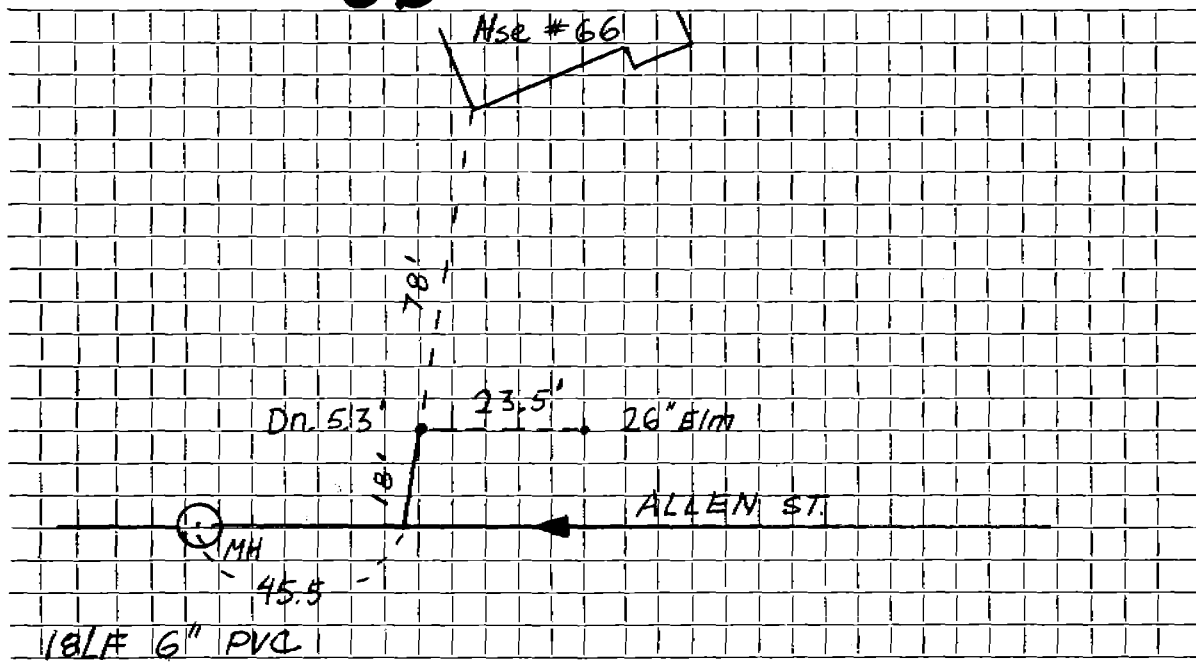

Connection made in .. ALLEN .. Street. Work completed

Remarks: