


DATE 4/3/96

TOWN OF LEXINGTON — BOARD OF PUBLIC WORKS
SEWER DIVISION

68 Sketch of Service Here

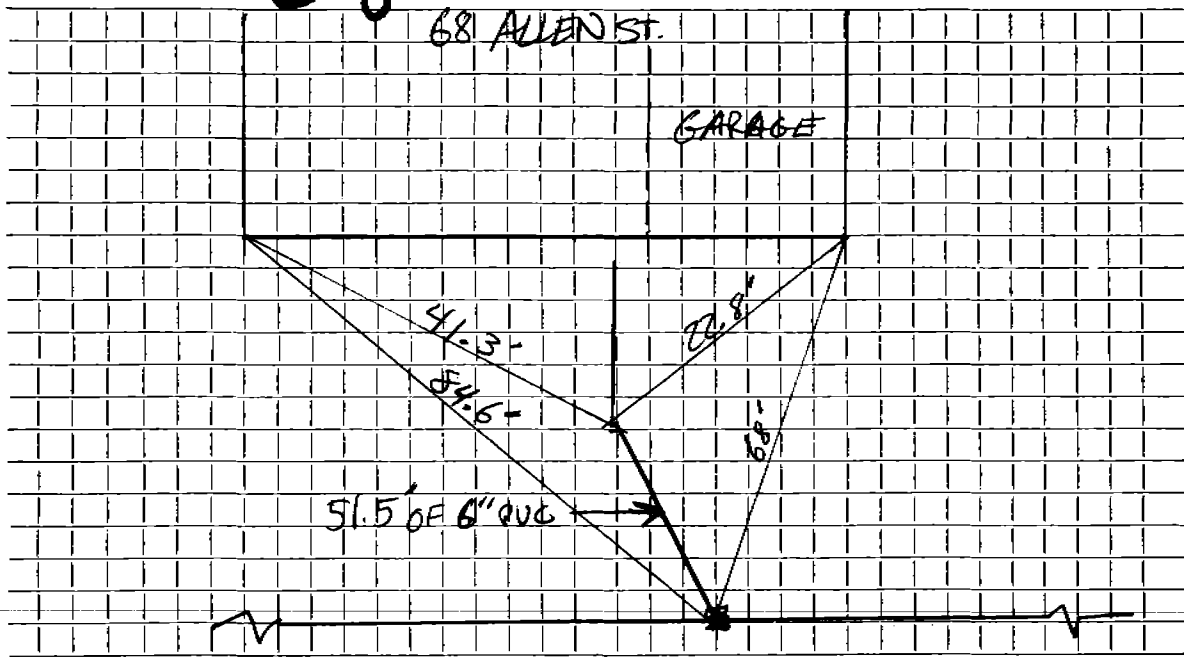

Connection made in Street. Work completed

Remarks:
.....