

Name MARY GARSIDE

Service No.

Address #73 ALLEN STREET

Location

Kind of Pipe

Size

A. Rochem Circle <sup>1 1/2" dia</sup> Size of Main

Repair—Renewal—

New Service

CESSPOOL ABANDONMENT

PERMIT NO. 0724

Location

Date

Material

Amount

Total

Date

Amount


1995

2- 90° SWEEPS  
WITH CLEANOUTS  
6" Ø P.V.C.

DATE 1995

TOWN OF LEXINGTON — BOARD OF PUBLIC WORKS  
SEWER DIVISION

Sketch of Service Here

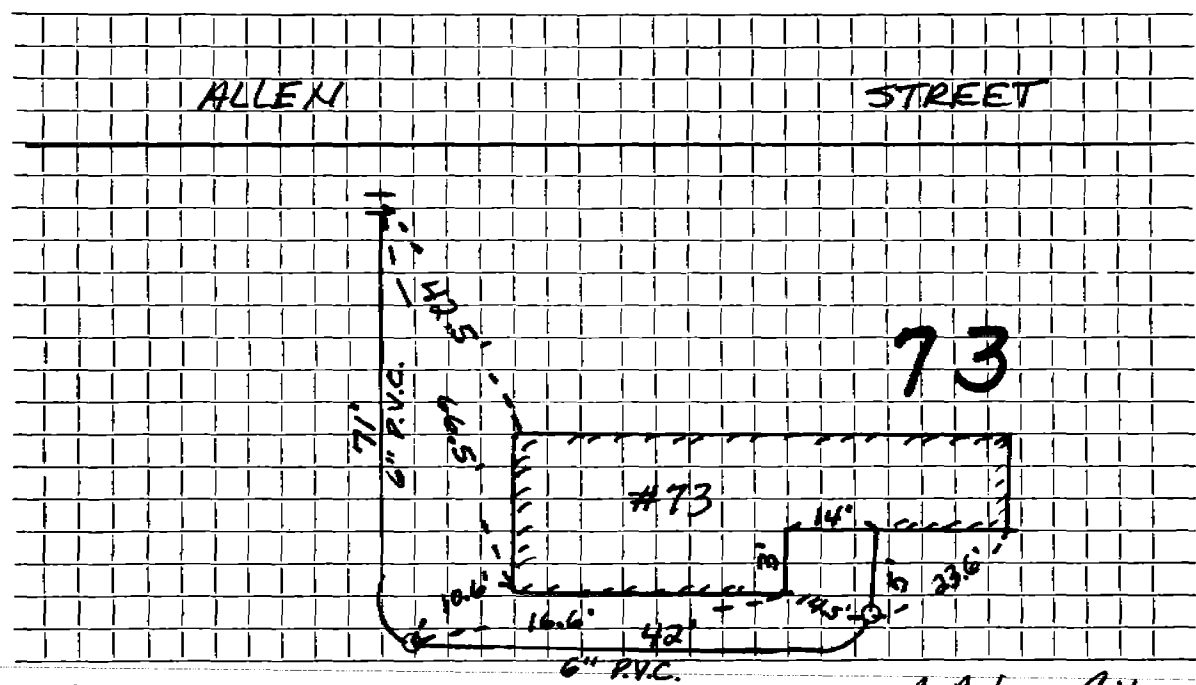

Connection made in ALLEN STREET Street.

Work completed A-Achem Citywide Plumbing

Remarks: .....