

Name F. D. Ezekiel

Service No. 39

Address 75 Allen Street

Location

Kind of Pipe

Size

Size of Main

Repair—Renewal—New Service W.O. #2680 Craftsman #1356

Location Comm Jul 7 1969

Date	Material	Amount	Total	Date	Amount
7-7-66	Labor	76.80		5-19-69	139.67
	10% O.H.	7.68	84.48	<i>Deposit</i>	
	20' 6" Transite pipe @.88		17.60		
	1 6" Elbow		4.09		
	3 hrs. Trucking @3.00		9.00		
	3 hrs. Shovel @6.50		19.50		
	1 hr. Compressor		5.00		
	(BILLED WHEN CONNECTED)		139.67		
5-22-69	15' 6" Transite pipe				
	10' 4" Cast Iron pipe				


DATE \_\_\_\_\_

TOWN OF LEXINGTON — BOARD OF PUBLIC WORKS

SEWER DIVISION

Sketch of Service Here

75

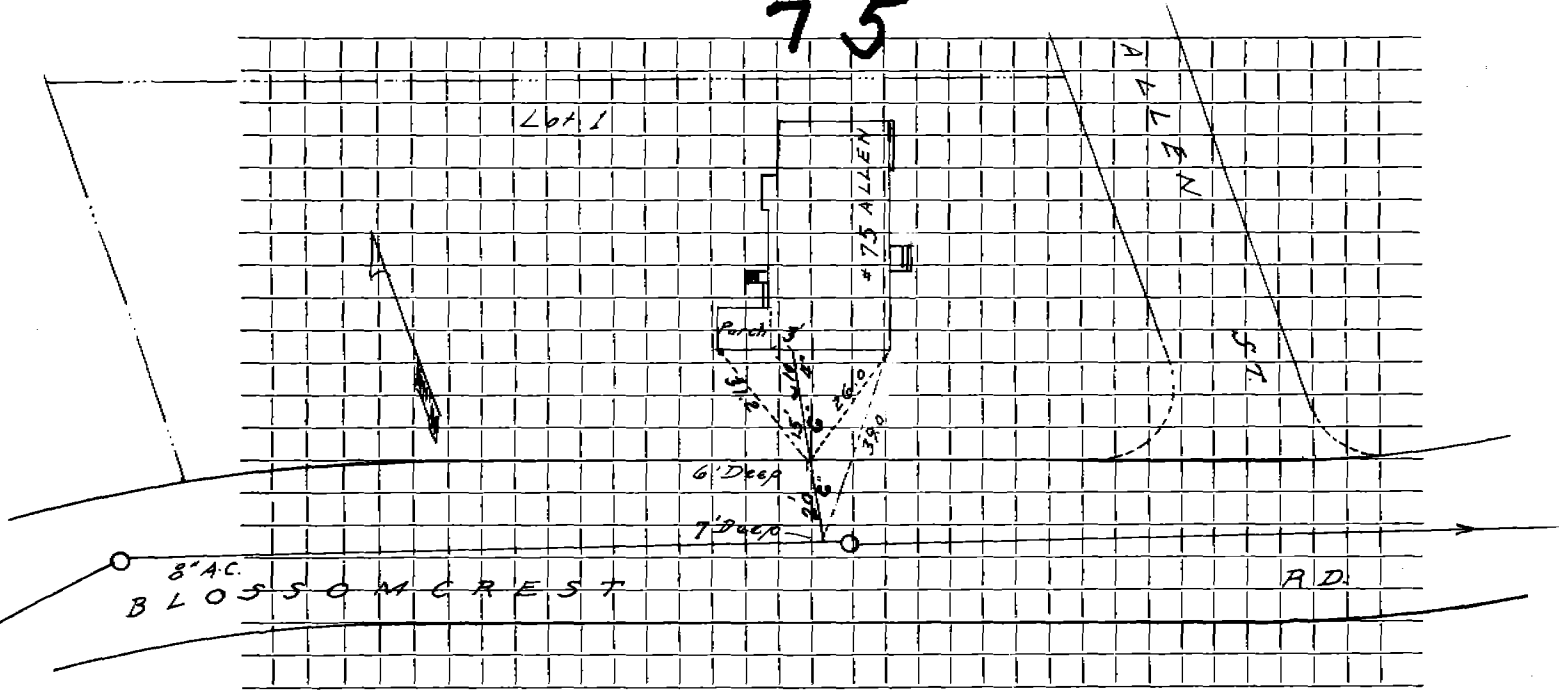

Connection made in ..... Street. Work completed .....

Remarks: .....  
.....  
.....