




DATE \_\_\_\_\_

TOWN OF LEXINGTON — BOARD OF PUBLIC WORKS  
SEWER DIVISION

19

8 Sketch of Service Here

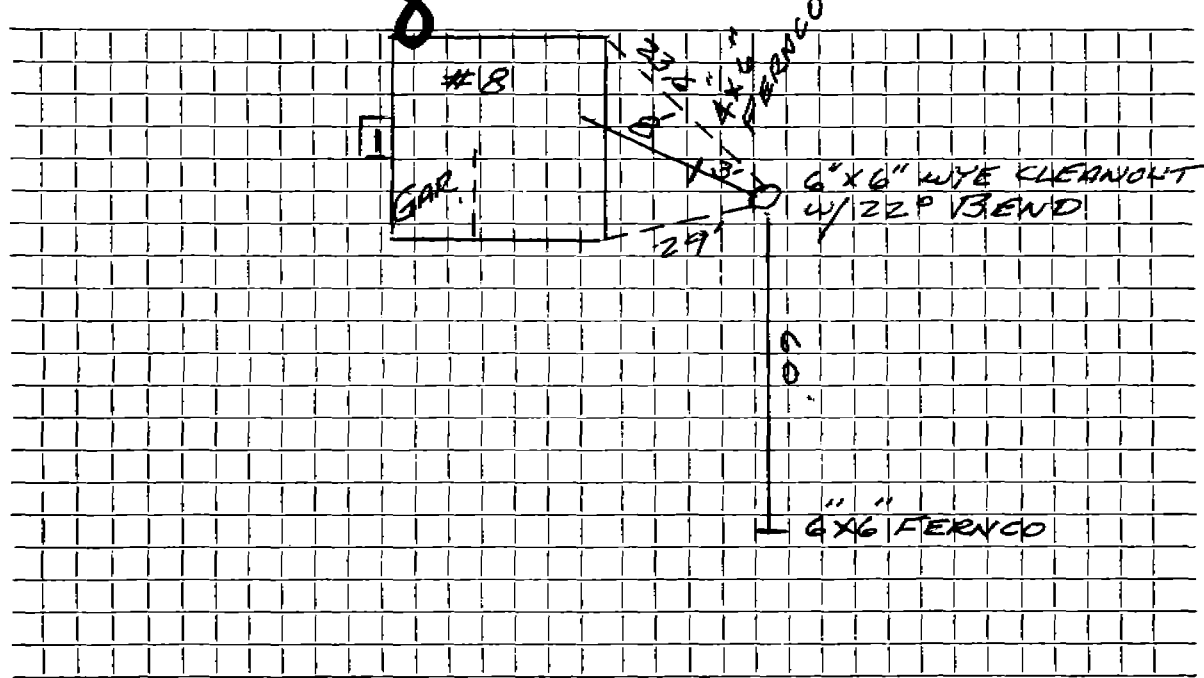

Connection made in ALLEN Street. Work completed .....

Remarks: .....  
.....  
.....