

Name

Service No.

Address

9 ALPINE STREET

Location

Kind of Pipe

PVC

Size 6"

Size of Main 8"

Repair—Renewal

New Service

~~RENEWAL~~

PROJECT 99-12/FIDRE CONST.

Location

Date

Material

Amount

Total

Date

Amount

11-3-1999


13' 6" PVC

\$390.00

DATE 11-3-1999

TOWN OF LEXINGTON — BOARD OF PUBLIC WORKS
SEWER DIVISION

Sketch of Service Here

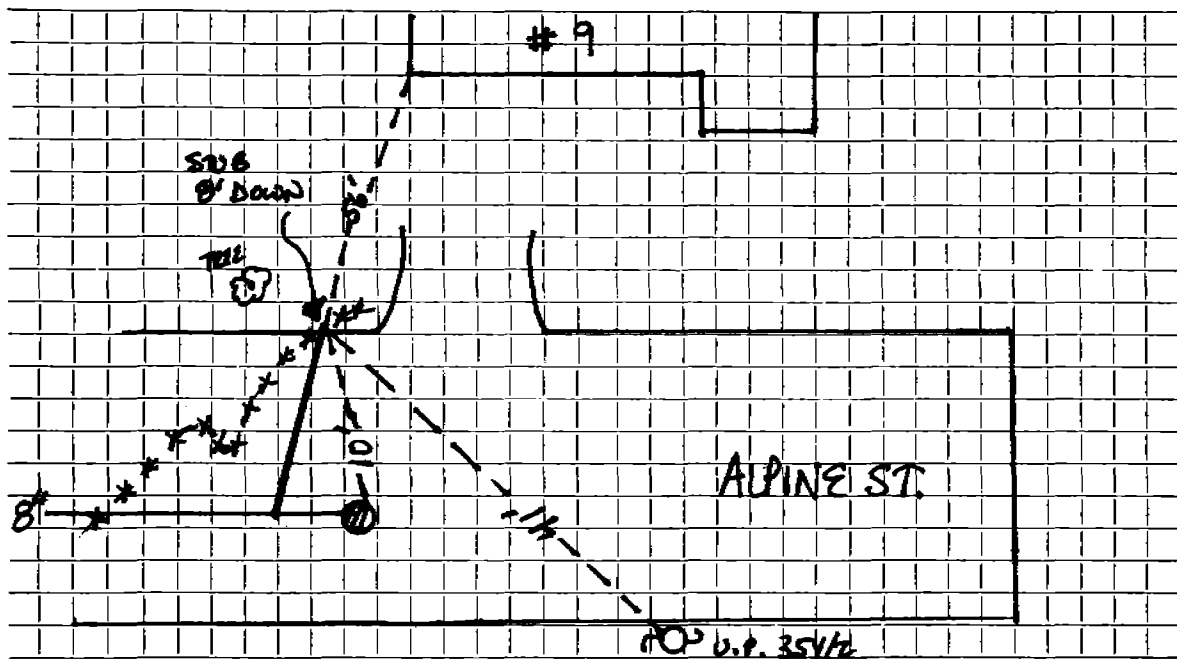

Connection made in Street. Work completed

Remarks: ~~XXXX~~ → REPRESENTS 1" COPPER WATER SERVICE WHICH CROSSES ABOVE & OVER SEWER L.I.E.

FIELD BOOK 99-12-1 PG 51

D.F.