

Name Ernest Berglund

Service No. 6 14

Address 1 Ames Avenue, Lexington, Mass. (to be connected from Carville Ave)

Location

Kind of Pipe

Size

Size of Main

~~Repair~~ ~~Renewal~~ New Service

Location

Date	Material	Amount	Total	Date	Amount
4/1/42	1½ hrs. @ 55¢	83		March 24, 1942	70.00
<i>Com 4/6/42</i>	40½ " @ 60¢	24 30		April 16, 1942	13.92
	10 " @ 65¢	6 50			56.08
	10 " @ 75¢	7 50	39 13		
	10% Overhead		3 91		
	26' 6" Sewer Pipe @ 16¢		4 16		
	10' 4" Soil pipe @ 50¢		5 00		
	1 6" Elbow		70		
	Joint compound		1 68		
	Trucking, 2 hrs. @ 75¢		1 50		
			56 08		
	Labor				

Hadley Press, Inc., Lexington

TOWN OF LEXINGTON—BOARD OF PUBLIC WORKS

SEWER DIVISION

DATE March 24, 1942

NO. \_\_\_\_\_

The undersigned applies for the construction of a particular sewer connecting No. 1 Street and hereby agrees to comply with the Rules and Regulations governing the construction and use of Particular Sewers, as now or at any future time established by the Board of Selectmen.


Am't. of Estimate \$ \_\_\_\_\_

Am't. Paid \$ \_\_\_\_\_

Josephine Berglund Owner

1 AMES

Sketch of Service Here

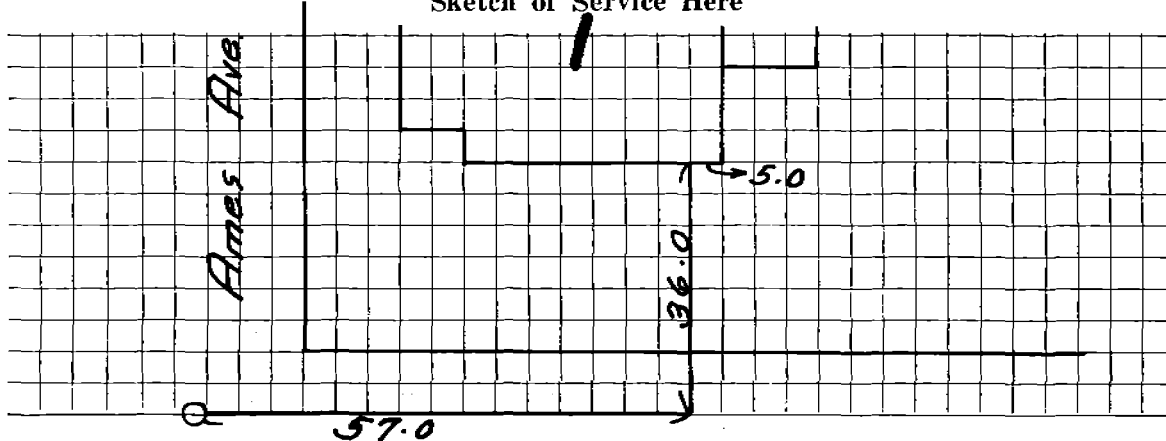

Connection made in \_\_\_\_\_ Street.

Work completed \_\_\_\_\_ 19

Remarks: