

Name John Walsh

Service No. 3

Address 10 Ames Avenue

Location

Kind of Pipe

Size

Size of Main

~~REPAIR~~ ~~REWORK~~ ~~REWORK~~ - New Service

WO #7024


Location *Cam* 5-28-62

Date	Material	Amount	Total	Date		Amount
1-19-62	Labor	64.60		1-9-62	Deposit	250.00
	10% C.E.	6.46	71.06	5-24-62	Refund	97.09
	45' 6" Transite Pipe @.78		35.10			152.91
	5 1/2 ton 3/4" Stone @1.50		8.25		NON CHARGE	
	5 hrs. Town Shovel @6.50		32.50	1-19-62	Labor	16.40
	2 hrs. Trucking @3.00		6.00		(Town Error)	
			152.91			

DATE \_\_\_\_\_

TOWN OF LEXINGTON — BOARD OF PUBLIC WORKS  
SEWER DIVISION

Sketch of Service Here

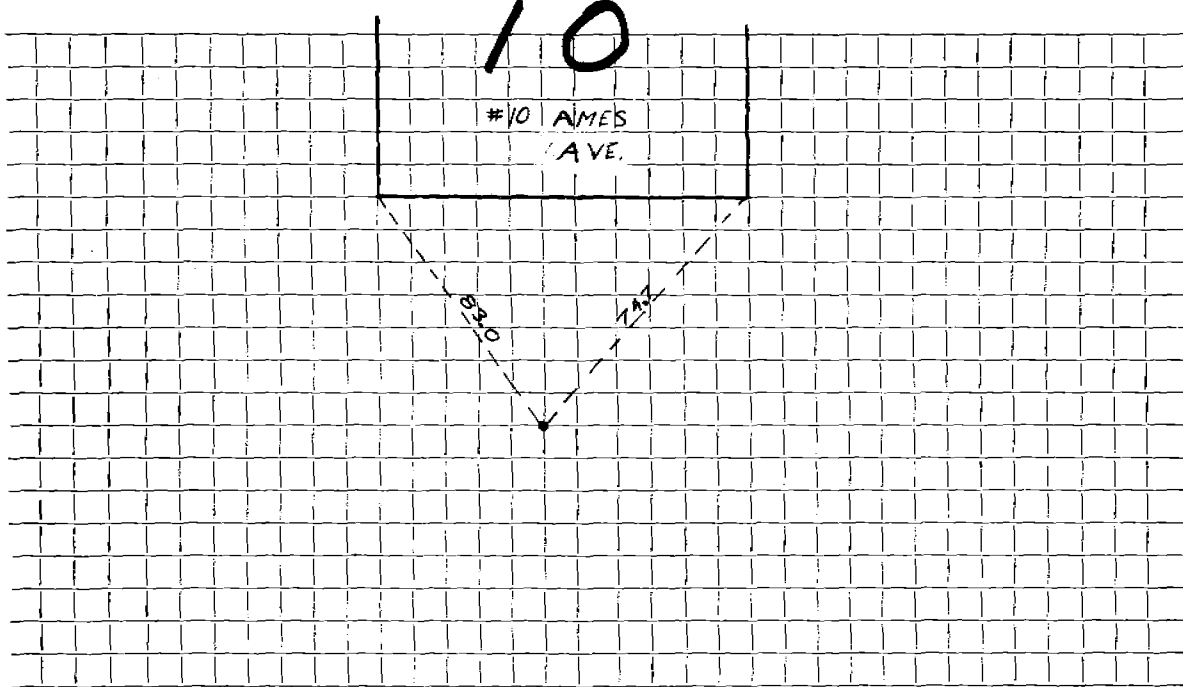

Connection made in ..... Street. Work completed .....

Remarks: .....  
.....  
.....