

Name Donna Realty

Service No. 159

Address 11 Ames Avenue

Location

Kind of Pipe

Size

Size of Main

~~Repair/Removal~~ New Service Suburbanite Cesspool # 1196

Location Jan 5-8 67


Date	Material	Amount	Total	Date	Amount
8-22-63	Labor	82.27		11/30/67	138.96
	10 % O.H.	8.23	90.50		
	28' 6" Transite pipe @.82		22.96		
	3 hrs. Town Shovel @6.50		19.50		
	2 hrs. Trucking @3.00		6.00		
	BILL WHEN CONNECTED		138.96		
12/10/66	28' 6" Copper				

Deposit

DATE _____

TOWN OF LEXINGTON — BOARD OF PUBLIC WORKS
SEWER DIVISION

Sketch of Service Here

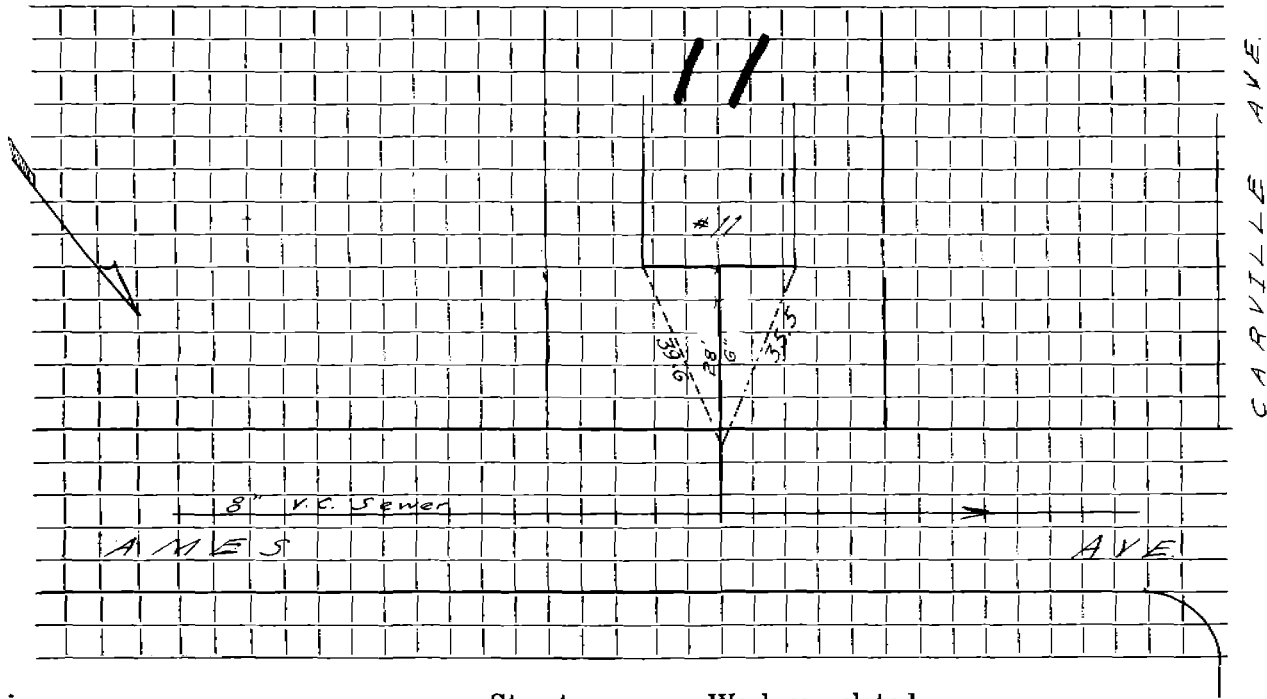

CARVILLE AVE.

Connection made in Street. Work completed

Remarks:
.....
.....