

Name Edward F. Tocio

Service No.

56

Address 14 Ames Ave

Location

Kind of Pipe

Size

Size of Main

~~Repair - Renewal - New Service~~

Location Comm 7-5-60


Date	Material	Amount	Total	Date	Amount
5-5-60	Labor 79.02 10 % O.H. 7.90		86 92	4-26-60 7-5-60	Deposit Paid by WHP #51 20 57
	50' 6" Transite Pipe @ .78		39 00	7-19-60	Paid 7 43
	5 1/4 Ton 1 1/4 Stone @ 1.50		7 87		178 00
	12 3/4 Ton Bank Gravel @ .85		10 83		
	1 6" Clay Elbow		1 88		
	3 Hrs. Town Shovel @ 6.50		19 50		
	3 Hrs. Trucking @ 3.00		9 00		
	1 Hr. Trailer @ 3.00		3 00		
			178 00		

DATE _____

TOWN OF LEXINGTON — BOARD OF PUBLIC WORKS

SEWER DIVISION

Sketch of Service Here

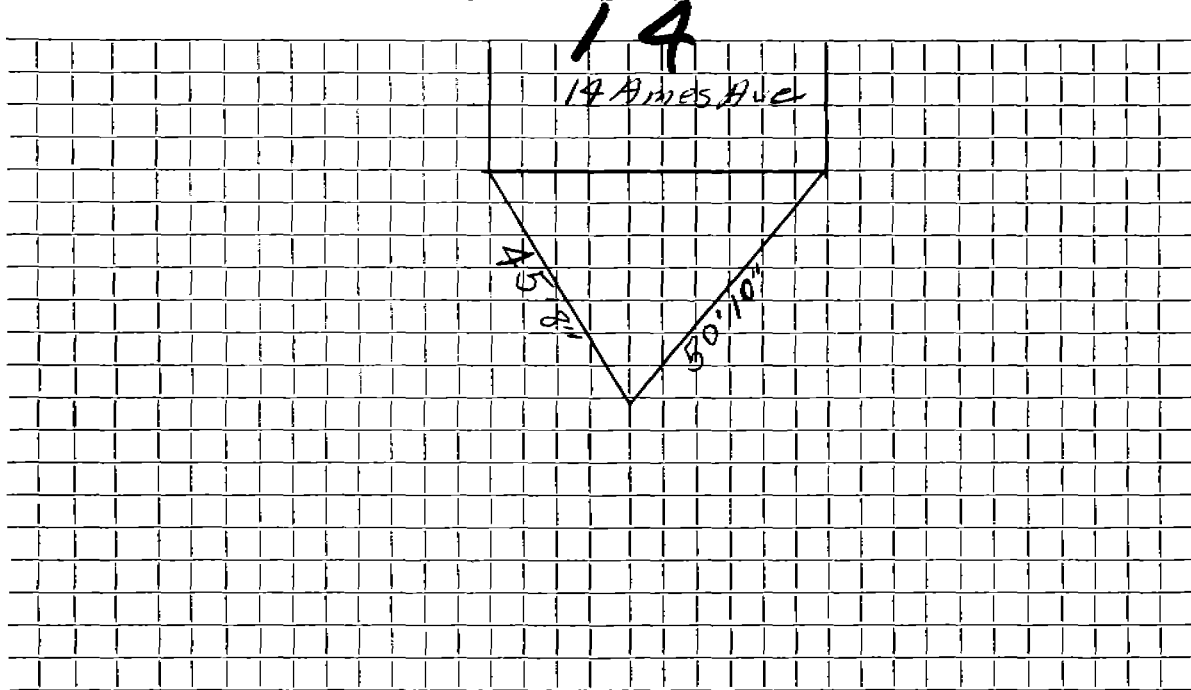

Connection made in Street. Work completed

Remarks:

.....

.....