 

Name William Sullivan						Service No. 210						
Addr	ess	15 Ames Avenue)									
							Location		2 umm, 3-3-3	-8		
Kind of Pipe					Size				Size of Main			
Repa	i R	renewal-New Service			Location							
Date		Material	Amount		Total	Total				Amount		
12/12/5	7]	Labor	61	06			11-7-5	-7	Deposit	\$ 100	50	
12/13/5	7	11	14	18			3-3-5	<u>8_</u> i	A. by reaind and h. H. C. #259			
			75	24					W. H. C. #259	28	29	
10% c		6 overhead	7	52	82	76	·			1.28	29	
	50 - 6" Transite pipe			b	35	00	5-9-3	8	Paid	14	47	
	3 1	hrs. Town shovel @	6.50		19	50				#142	76	
	2 1	urs. Trucking @ .7	5		1	50						
	41	nrs. Pump @ 1.00			4	00						
			[142	76						
			· · · · · · · · · · · · · · · · · · ·		 				· · · · · · · · · · · · · · · · · · ·			
		Labor										
			· · · · · · · · · · · · · · · · · · ·				3-5-	58	Bill sent # 1	4.47		
									· · · · · · · · · · · · · · · · · · ·			
									·	<u> </u>		
H.B.M.18501					1			:				

TOWN OF LEXINGTON-DEPT. OF PUBLIC WORKS SEWER DIVISION



NO.

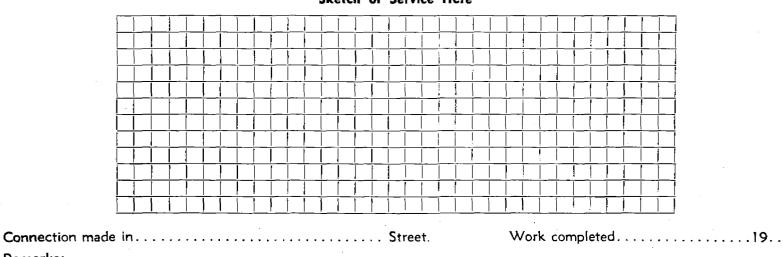

Sketch of Service Here

Remarks: