

Name Edward F. Tocio

Service No. 57

Address 18 Ames Avenue

Location

Kind of Pipe

Size

Size of Main

~~Repair~~ ~~Reconnect~~ New Service


Location *Conn 7-5-60*

Date	Material	Amount	Total	Date	Amount
5-5-60	Labor 79.02			4-26-60	Deposit 150 00
	10 % O.H. 7.90		86 92	7-5-60	Paid by <i>W.H. #57</i> 30 57
60'	6" Transite Pipe @ .78		46 80	7-19-60	Paid 8 63
12	Ton 1 1/4 Stone @ 1.50		18 00		<u>179 22</u>
3	Hrs. Town Shovel @ 6.50		19 50		
2	Hrs. Trucking @ 3.00		6 00		
2	Hrs. Pumping @ 1.00		2 00		
			179 22		

DATE _____

TOWN OF LEXINGTON — BOARD OF PUBLIC WORKS
SEWER DIVISION

Sketch of Service Here

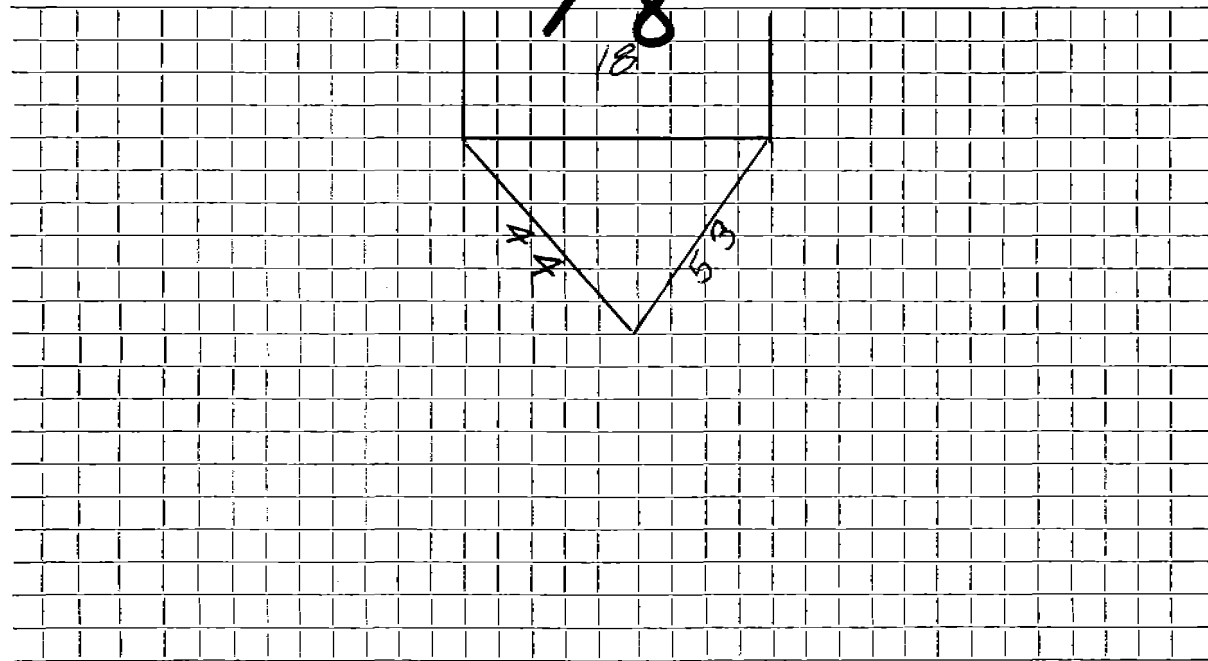

Connection made in Street. Work completed

Remarks:
.....
.....