

Name Donna Realty Trust

Service No. 226

Address ²³~~28~~ Ames Avenue

Lot 498-499 Sta. 3+55.6 Right

Location

Kind of Pipe

Size

Size of Main

~~Repair~~ ~~Renewal~~ ~~New Service~~ Suburbanite Cesspool Permit #A128

Location MAR 14 1966


Date	Material	Amount	Total	Date	Amount
8-15-63	Labor	99.27		11-22-65	
	10% C.H.	9.93	109.20	<i>Deposit</i>	149.68
	14' 6" Transite pipe @.82		11.48		
	4 hrs. Town Shovel @6.50		26.00		
	1 hr. Trucking @3.00		<u>3.00</u>		
			149.68		
11-23-65	21' 6" Transite pipe				

DATE _____

TOWN OF LEXINGTON — BOARD OF PUBLIC WORKS

SEWER DIVISION

Sketch of Service Here

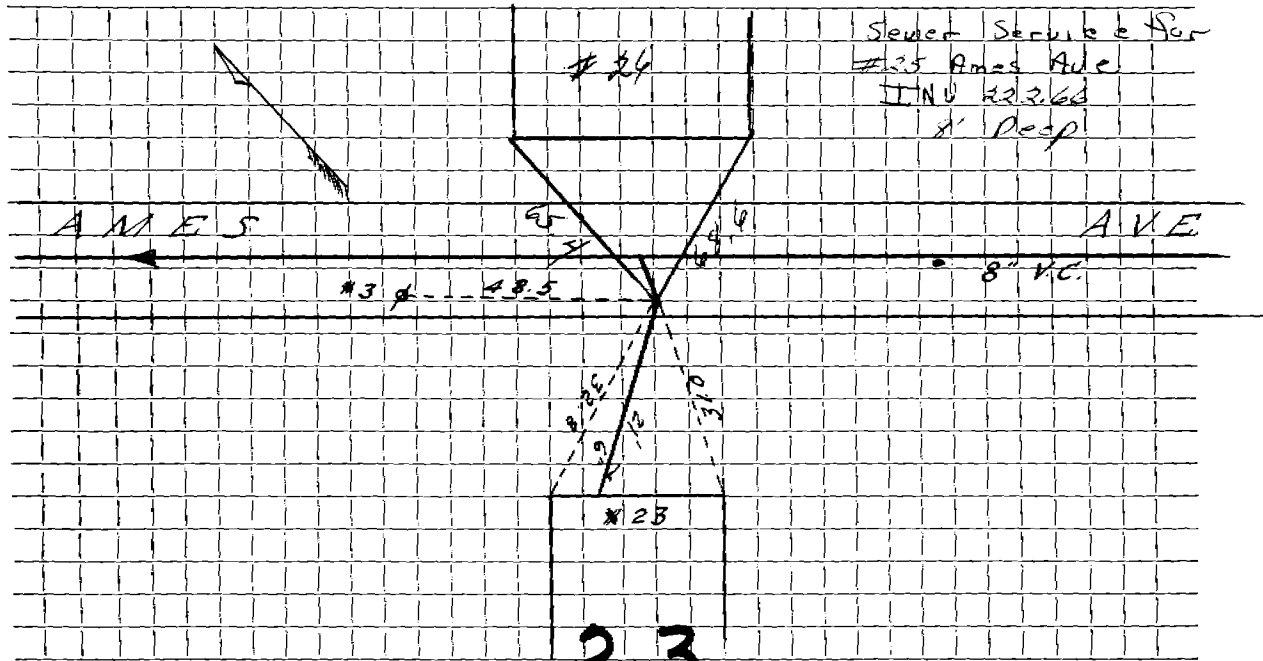

Connection made in Street. Work completed

Remarks:
.....
.....