Name	Donald Irwin				Service No.	16
Addre						
		Location		Comm. 4/29/57		
Kind of Pipe			Size		Size of Main	
Repai	xxRenaval-New Service				Location	
Date	Material	Amount	Total	Date		Amount
3/26/57	Labor	51 43		3-8-57	Deprit	#15000
	10% overhead	5 14	56 57	4-27-57		23 81
	6d' - 6" Transite H	pe @ .7020	42 12		0	# 126 19
1	hrs. Town Shovel	e 6.50	26 00			
é	hrs. Trucking @	.75	1 50			
			126 19	3.22.04	Plumber hit	4 ecols
				-l	52' out,	
				-#	Respond +	MEASURE
				_	/	
			 			ļ
				<u> </u>		
	Labor					
					X	
HP-6411						

TOWN OF LEXINGTON-DEPT. OF PUBLIC WORKS

SEWER DIVISION


..... Owner

The undersigned applies for the construction of a particular sewer connecting No. Street and hereby agrees to comply with the Rules and Regulations governing the construction and use of Particular Sewers, as now or at any future time established by the Board of Selectmen.

Am't of estimate \$.....

DATE

Am't Paid \$....

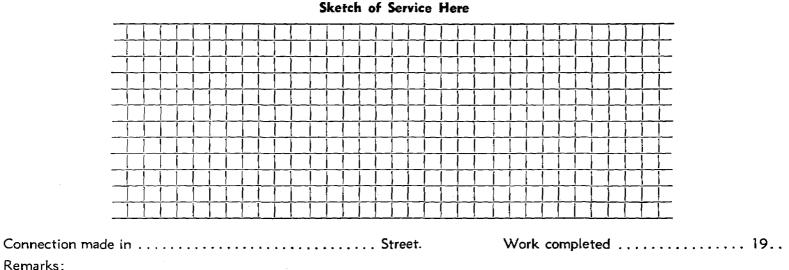

Remarks: