

Name

Service No.

Address

30 Ames Ave.

Location

Kind of Pipe

Size

Size of Main

Repair—Renewal—New Service

Location

Date

Material

Amount

Total

Date

Amount

8-15-63

17' 6" Transite
1 2 1/2" Transite Bend
1 1 1/4" Transite Elbow


11-23-65

28' 6" Transite

DATE _____

TOWN OF LEXINGTON — BOARD OF PUBLIC WORKS
SEWER DIVISION

Sketch of Service Here

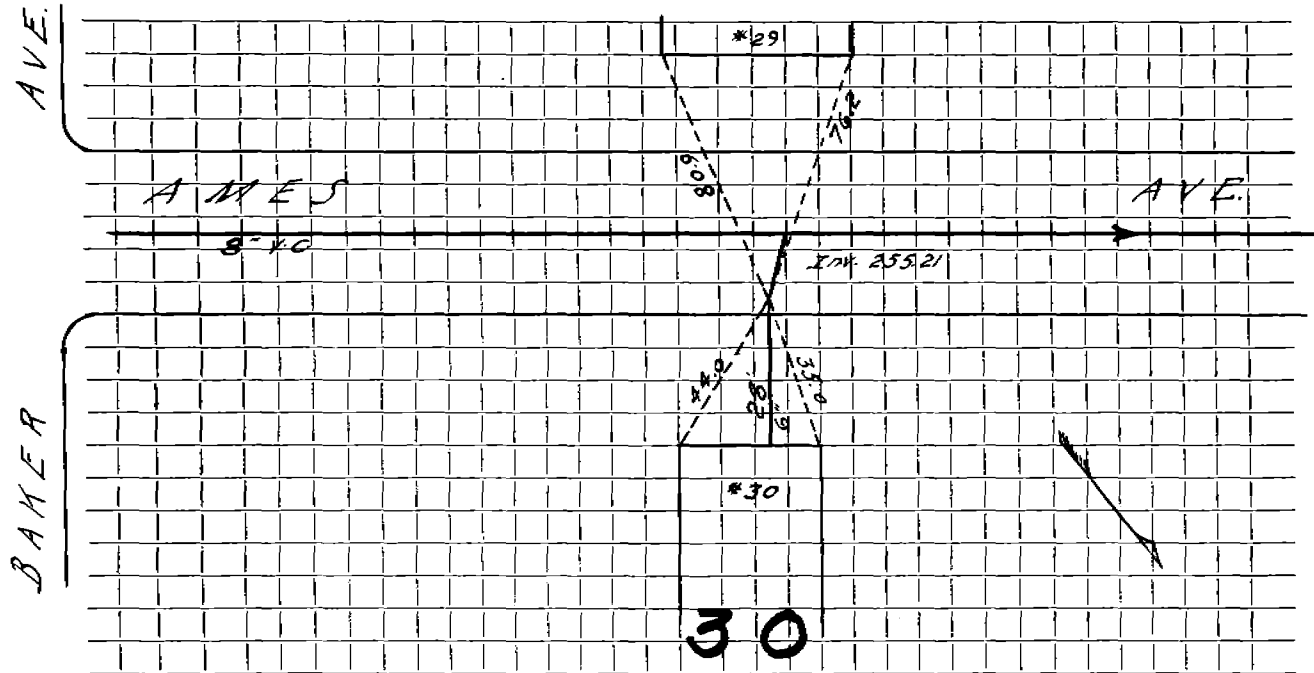

Connection made in Street. Work completed

Remarks:
.....
.....