

Name Ernest A. Grant

Service No. 25

Address 32 Ames Avenue

Location

Comm. 7/22/57

Kind of Pipe

Size

Size of Main

~~Repair~~ ~~Renewal~~ — New Service

Location

Date	Material	Amount	Total	Date	Amount
4/16/57	Labor	27 09		3-26-57	Deposit
4/17/57	"	26 87		7-22-57	Refund
		<u>53 96</u>			
	10% overhead	5 40	59 36		
	52' - 6" Transite Pipe @ .7020		36 50		
	4½ hrs. Town Shovel @ 6.50		29 25		
	2 hrs. Trucking @ 3.00		6 00		
	1 hr. Rodgers Trailer		3 00		
			<u>134 11</u>		

¹⁶
 200 00
65 89
 134 11

Labor

TOWN OF LEXINGTON—DEPT. OF PUBLIC WORKS
SEWER DIVISION

DATE.....

NO.


The undersigned applies for the construction of a particular sewer connecting No.....
Street and hereby agrees to comply with the Rules and Regulations governing the construction and use of Particular
Sewers, as now or at any future time established by the Board of Selectmen.

Am't of estimate \$.

Am't Paid \$.

..... Owner

Sketch of Service Here

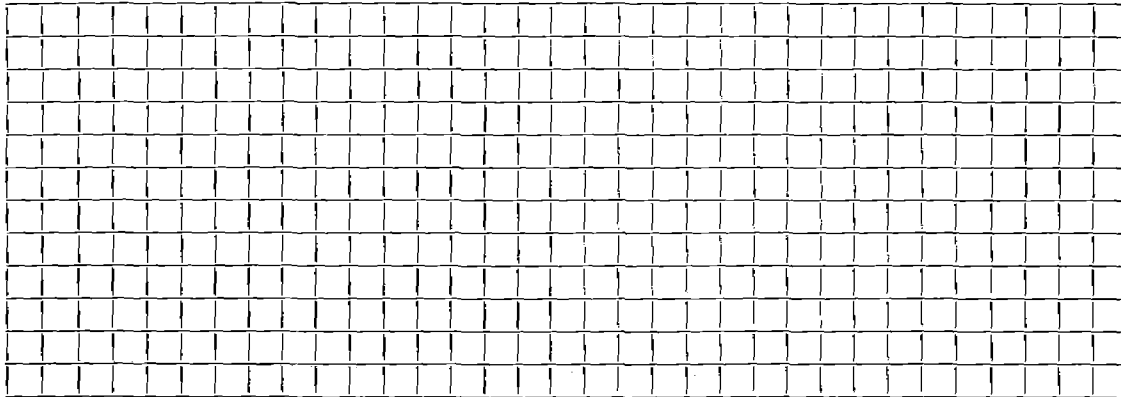

Connection made in..... Street.

Work completed.....19..

Remarks: