

Name Henry P. Hogan  
 Address 7 Ames Avenue, Lexington

Service No. 13 / 16

Location

Kind of Pipe

Size

Size of Main

~~Repair - Renewal~~ - New Service

Location

Date  
1943

Material

Amount

Total

Date

Amount

July 12

6 1/2 hrs. @ 60¢

3 90

34 45

*June 16, 1943 Deposited*  
*July 28, 1943 Refund*

50.00

23 1/2 " @ 65¢

15 25

3 44

2.14

11 " @ 70¢

7 70

5 00

47 86

9 1/2 " @ 80¢

7 60

10% Overhead

16' 6" Sewer Pipe @ 16¢

2 56

10' 4" Iron Pipe @ 50¢

5 00

1 6" Elbow

70

Joint compound

96

1 hr. trucking

75

Labor

TOWN OF LEXINGTON—BOARD OF PUBLIC WORKS

SEWER DIVISION

DATE June 1, 1943

NO. \_\_\_\_\_


The undersigned applies for the construction of a particular sewer connecting No. 7 Ames Ave Street and hereby agrees to comply with the Rules and Regulations governing the construction and use of Particular Sewers, as now or at any future time established by the Board of Selectmen.

Am't. of Estimate \$ 50<sup>00</sup>

Am't. Paid \$ \_\_\_\_\_

Henry P. Hogan Owner

Sketch of Service Here

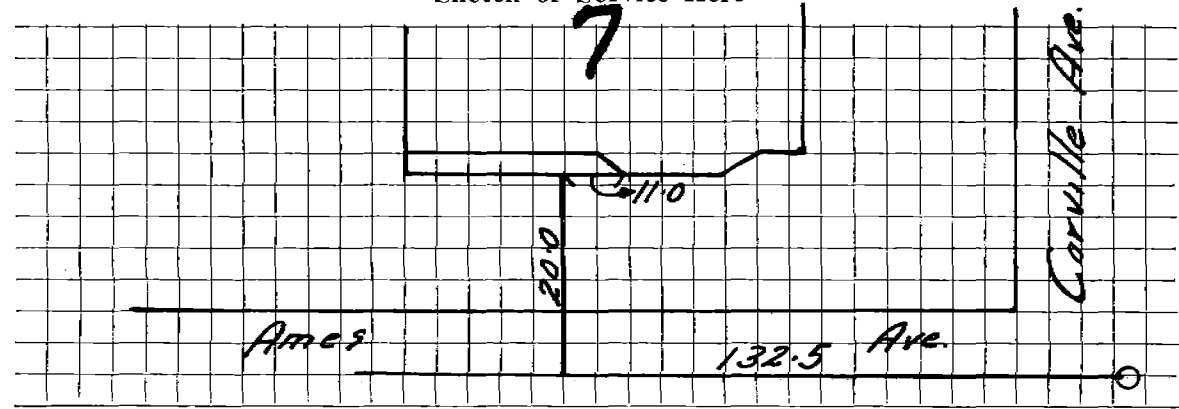

Connection made in \_\_\_\_\_ Street. Work completed \_\_\_\_\_ 19

Remarks: