


DATE 12-8-80

TOWN OF LEXINGTON — BOARD OF PUBLIC WORKS
SEWER DIVISION

Sketch of Service Here

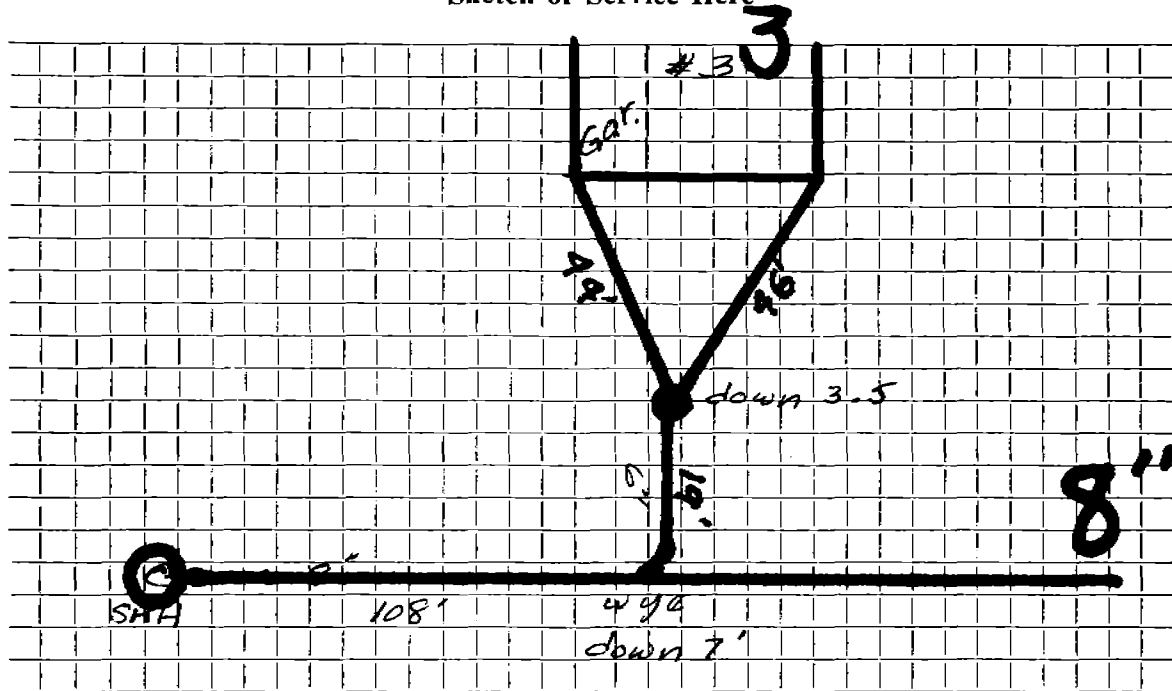

Connection made in AMHERST ST. Street. Work completed

Remarks:
.....
.....