

Name Costas Los

Service No. 19

Address 5 Amherst Street

Location

Kind of Pipe

Size

Size of Main 8"

~~Repair Request~~ New Service Valeri #3652

Location MAY 26 1981


Date		Material	Amount	Total	Date	Amount
12/1/80	20'	6" P.V.C. @ 14.00		280. 00	4-30-81	280 00
5/12/81	105'	6" P.V.C.				

Deposit

DATE _____

TOWN OF LEXINGTON — BOARD OF PUBLIC WORKS
SEWER DIVISION

Sketch of Service Here

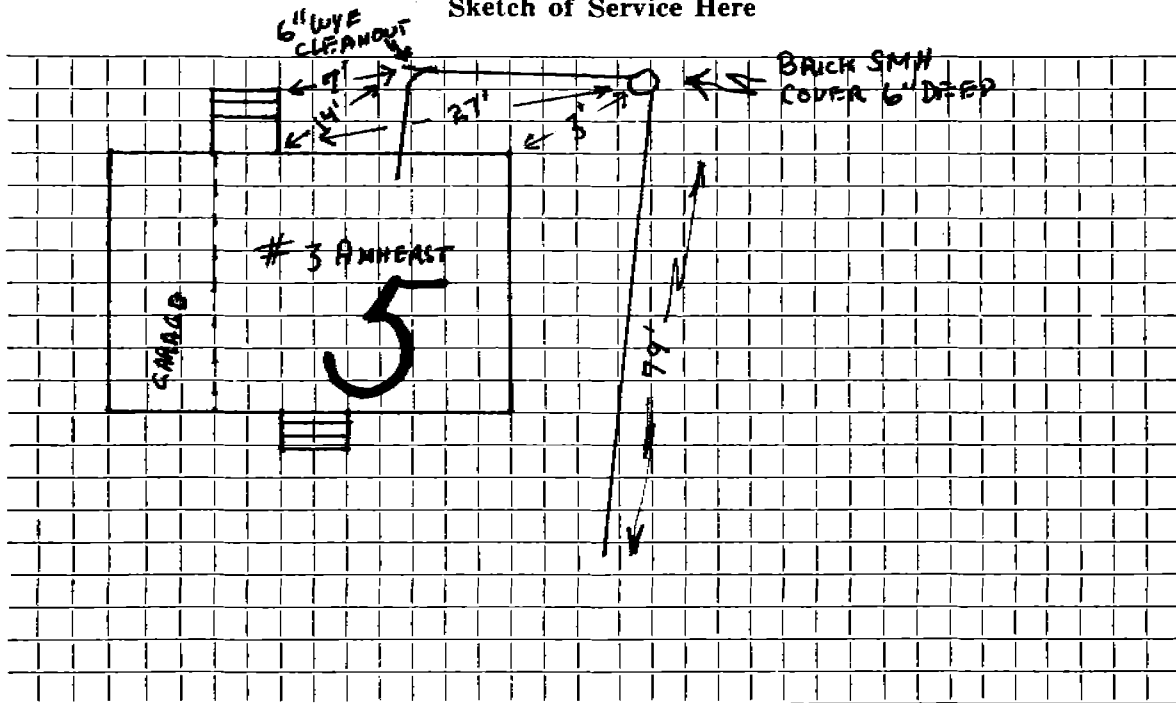

Connection made in Street. Work completed

Remarks:
.....
.....