


DATE 12-8-80

TOWN OF LEXINGTON — BOARD OF PUBLIC WORKS

UPDATED 2/19/97

SEWER DIVISION

Sketch of Service Here

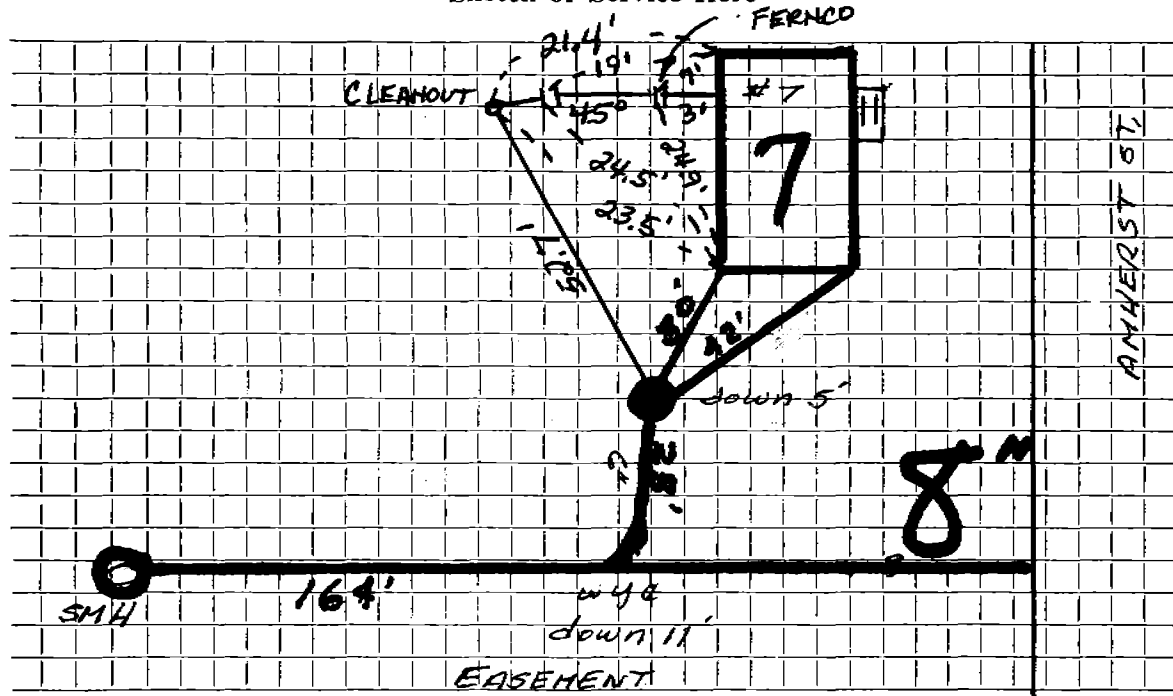

Connection made in Easement Street. Work completed

Remarks: Service out rear

BOOK 96-5

J.W.