

Name

Service No.

Address #2 APOLLO CIRCLE (LOT #4)

Location

Kind of Pipe 6" ACP

Size 6"

Size of Main 8"

Repair—Renewal—New Service

DeFelice #3024

Location

Date

Material

Amount

Total

Date


Amount

8/16/77

20' - 6" ACP
31' 6" ACP
10' - 4" CI

TOWN OF LEXINGTON — BOARD OF PUBLIC WORKS
SEWER DIVISION

Sketch of Service Here

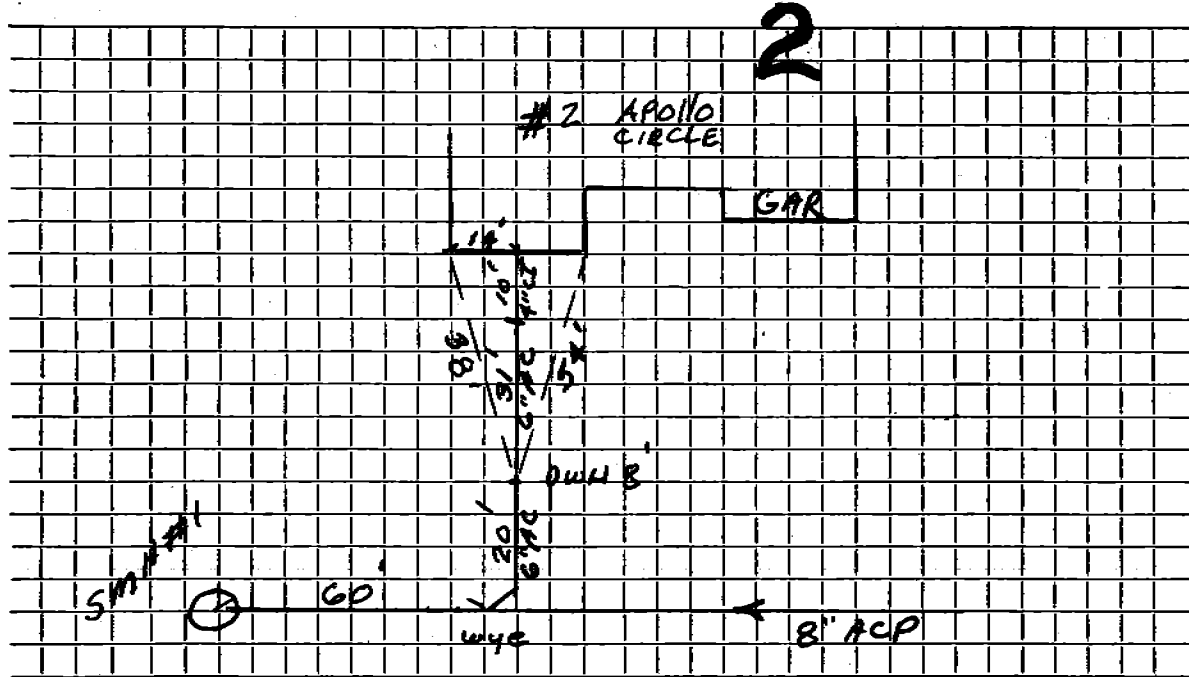

Connection made in ... APOLLO CIRCLE ... Street. Work completed

Remarks:
.....
.....