

Name

Service No.

Address # 6 Apollo Circle

Location

Kind of Pipe

Size

Size of Main

Repair—Renewal—New Service


Location

Date	Material	Amount		Total		Date			Amount
4-14-78	32'-6" ACP								
	10'-4" CI								

DATE \_\_\_\_\_

**TOWN OF LEXINGTON — BOARD OF PUBLIC WORKS**  
**SEWER DIVISION**

Sketch of Service Here

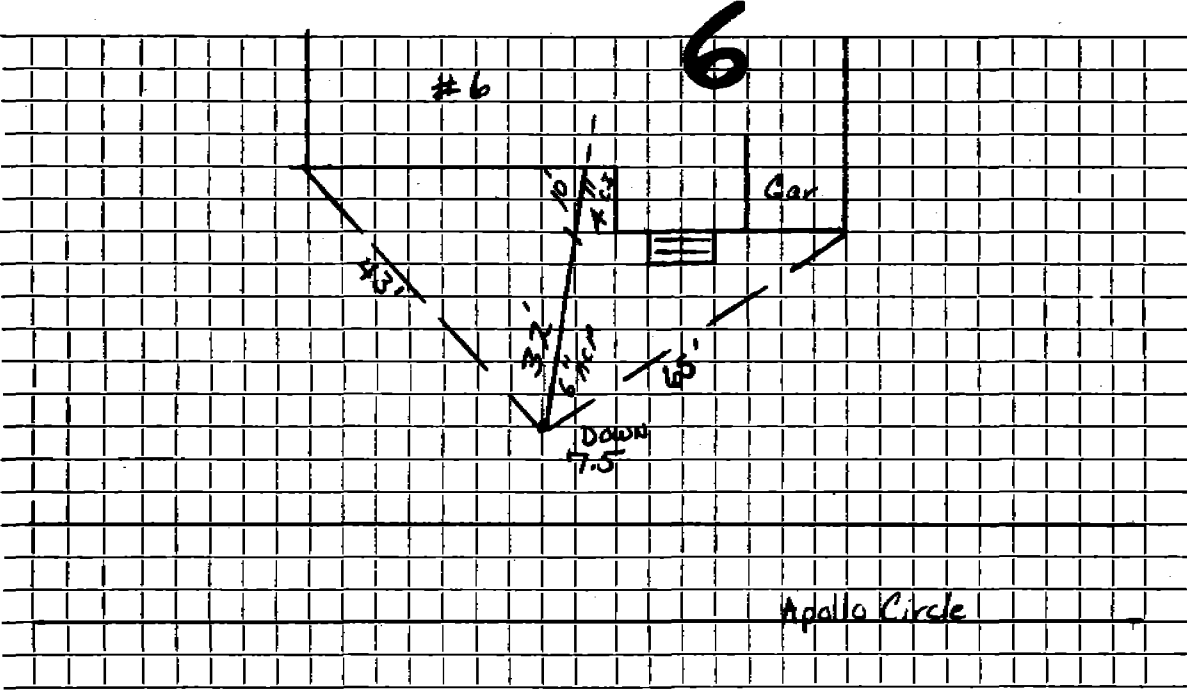

Connection made in ..... Street. Work completed .....

Remarks: .....  
.....  
.....