

Name

Service No.

Address # 7 APOLLO CIRCLE (LOT G)

Location

Kind of Pipe A.C.

Size 6"

Size of Main 8"

Repair—Renewal—New Service DEFICIT #3027

Location

Date	Material	Amount	Total	Date	Amount
------	----------	--------	-------	------	--------

8/29/77

72' - 6" ACP


25' - 6" ACP

10' - 4" CI

DATE _____

TOWN OF LEXINGTON — BOARD OF PUBLIC WORKS
SEWER DIVISION

Sketch of Service Here

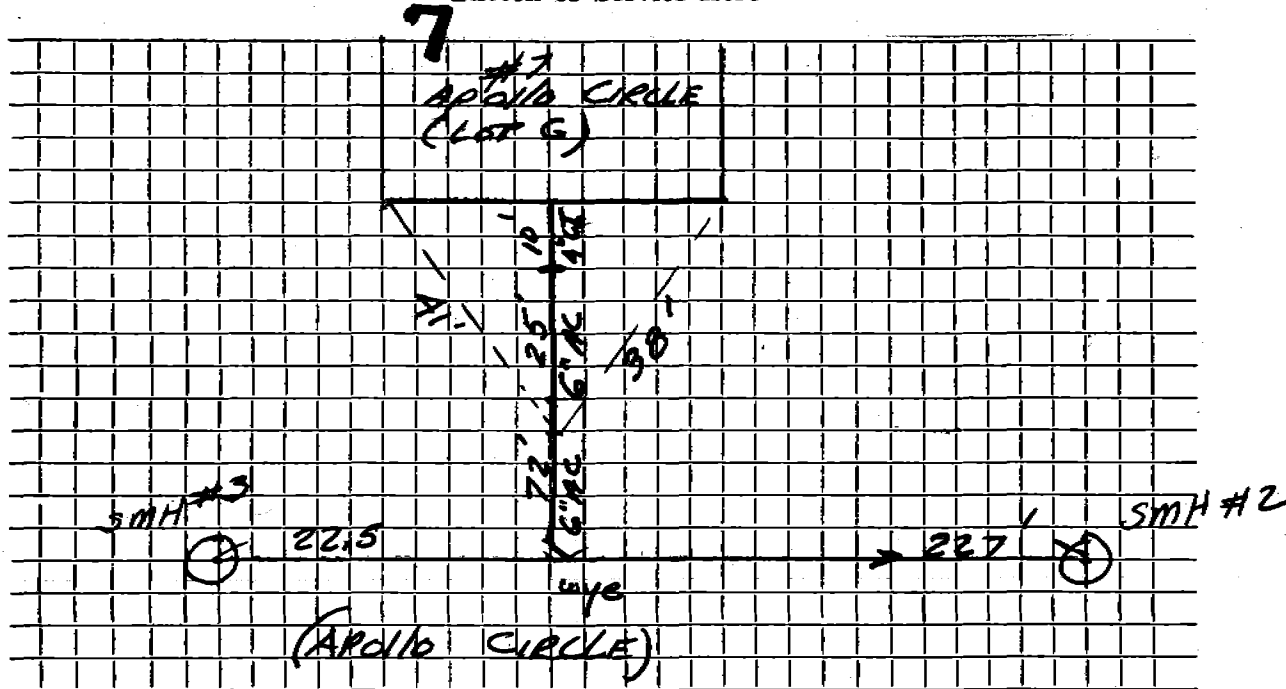

Connection made in ... APOLLO CIRCLE ... Street. Work completed

Remarks:

.....

.....