

Name

Service No.

Address

9 APOLLO CIRCLE

Location

Kind of Pipe

AC.

Size

6"

Size of Main

Repair—Renewal—New Service

#3371  
DEFELICE BROS.

Location

Date

Material

Amount

Total

Date

Amount

1-3-78


10' - 4" CI

27' - 6" ACP

DATE \_\_\_\_\_

TOWN OF LEXINGTON — BOARD OF PUBLIC WORKS  
SEWER DIVISION

Sketch of Service Here

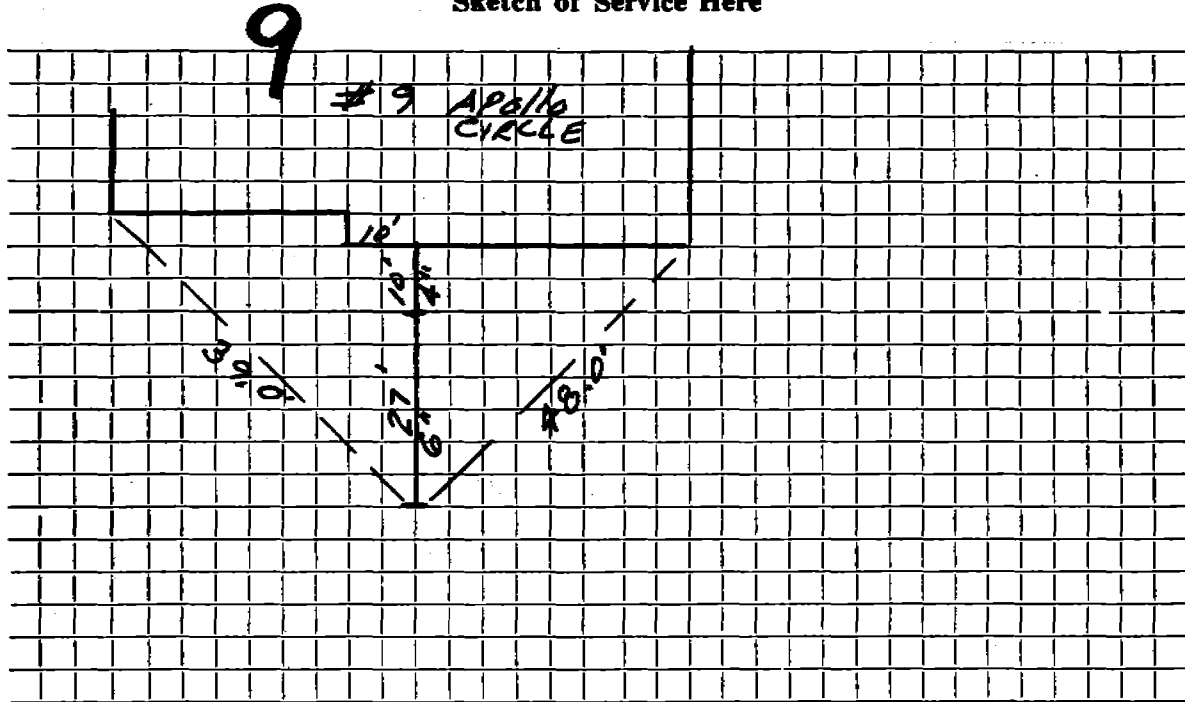

Connection made in .... APOLLO... CIRCLE ..... ~~Street~~ Work completed .....

Remarks: .....

.....

.....