

Name

Service No.

Address

1 APPLE TREE

Location

Kind of Pipe

Size

Size of Main

Repair—Renewal—New Service

NEW SERVICE

Location

Date

Material

Amount

Total

Date

Amount

5/2 96 6" PVC SEWER

6-27-75


26' 6" A.C. Pipe

6

DATE 5/2/96

TOWN OF LEXINGTON — BOARD OF PUBLIC WORKS
SEWER DIVISION

Sketch of Service Here

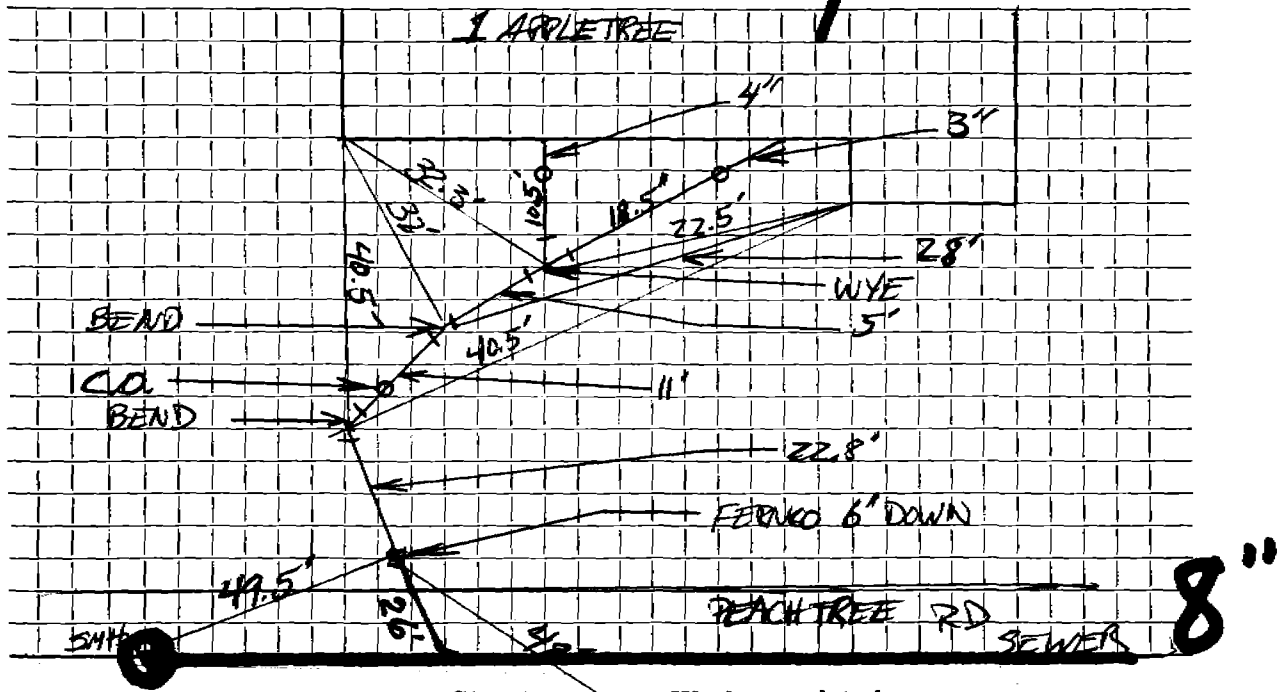

Connection made in Street. Work completed

Remarks:
.....
.....