

1977

Name Carol J. Brady Service No. 13

Address 10 APPLETREE LN. ² JUNE 20 1977

Location

Kind of Pipe AC Size 6" Size of Main 8"

~~Repair~~ ~~Remove~~ New Service VALERI #3155 Location


Date		Material	Amount	Total	Date	Amount	
7-15	75	19' 6" AC @	10.00 =	190.00 =	9/19/77	DEPOSIT	190.00
4/21/77		71' 6" ACP					
		10' 3" CF					
		10' 4" CF					
		Two (2) 6" X 6" wyes					

DATE _____

TOWN OF LEXINGTON — BOARD OF PUBLIC WORKS

SEWER DIVISION

Sketch of Service Here **10**

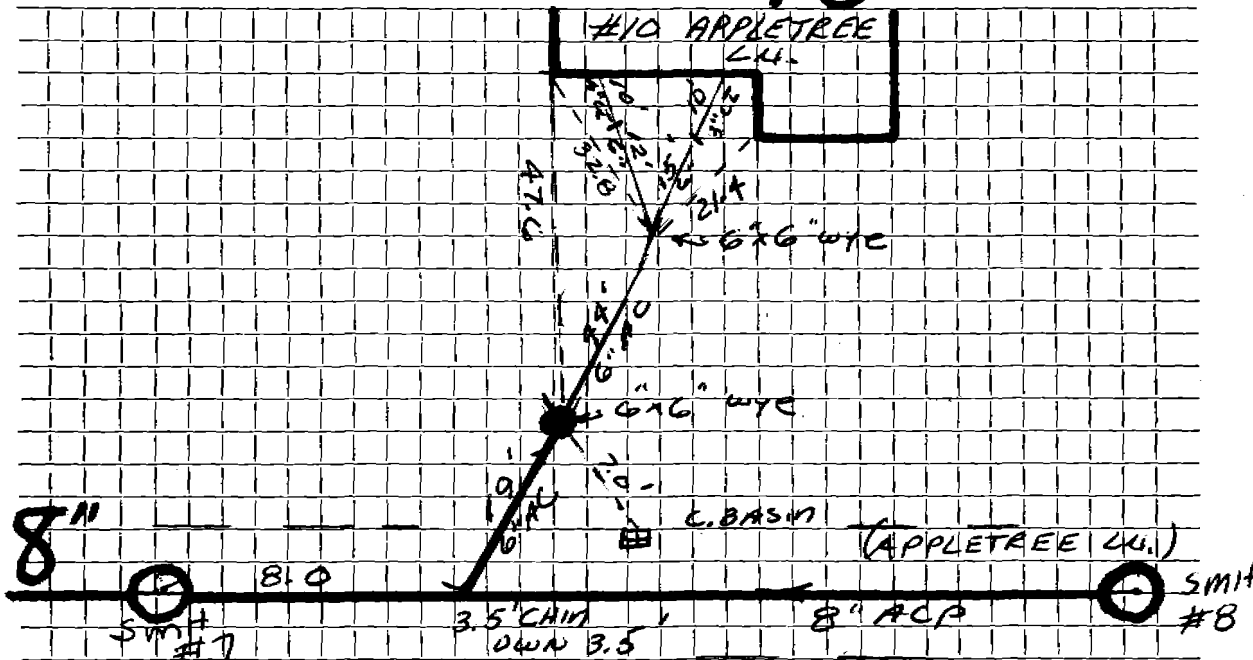

Connection made in APPLE TREE L.H. Street. Work completed

Remarks:
.....
.....